IREDELL COUNTY HEALTH DEPARTMENT

Statesville Phone TR 3-7271 Mooresville Phone NO 3-1271

PERMIT TO INSTALL SEPTIC TANK

Permit NO. _____ Permit Date APRIL 2, 1959

Owner GAITHER BLDG. CO. Address STATESVILLE, N.C.

Installed By " Address "


Location of Property ACCROSS FROM W.S.I.C. RECLAIMED BRICK HOUSE - BESIDE PINK SIDING HOUSE

Tank		Capacity		Length of Lines		Fixtures	
Block	(✓)	800	( )	150'	( )	No. of Baths	(1)
Precast	( )	900	( )	175'	( )	Dishwasher	( )
		1000	(✓)	200'	( )	Garbage Grdr.	( )
		1100	( )	225'	(✓)	Auto-Washer	( )
		1200	( )	250'	( )	Other	
		Other		Other			

NOTIFY HEALTH DEPARTMENT AT LEAST EIGHT HOURS BEFORE TANK IS TO BE INSPECTED.

Final Inspection APRIL 2, 1959 Approved (✓) Disapproved ( )

Remarks _____

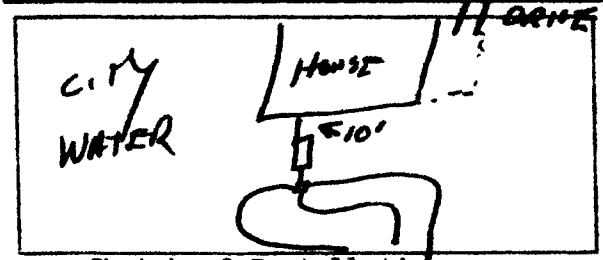

Sketch of Installation

Raford A Adams

Sanitarian