IREDELL COUNTY HEALTH DEPARTMENT

STATESVILLE 704-878-5305 MOORESVILLE 704-664-5281

IMPROVEMENT PERMIT / AUTHORIZATION TO CONSTRUCT / OPERATION PERMIT / EXISTING SYSTEM INSPECTION

PERMIT# 074433 PIN# 4736 01 1721 DATE 7-10-98

OWNER OR CONTRACTOR AUSTIN & AUSTIN BLDG. PHONE: Business Home 876-0105

ADDRESS 120 CHECKERS LANE, STATESVILLE, NC 28625

LOCATION NC 115 N, TL SCOTTS CREEK, TL OLD WILKESBORO ROAD, 4TH LOT ON RIGHT (5TH)?

SUBDIVISION BLOCK / SECTION LOT LOT AREA 0.6238 ACRE SITE CLASS PS DESIGN FLOW 360 L.T.A.R. 0.30 SPD/FT²

Septic Tank: 1000 Gallons; STB 1012 Date 4

Pump Tank: Gallons; PT Date

Pump Make: Model Serial No.

Nitrification Field: No Fields 1 Square Feet EQ. TO 1200 Linear Feet 300+

No Lines FIVE Trench Width 36" Max Trench Bottom Depth 36"

☑ New System ☐ Repair System Type: I, II, III, IV, V, VI

System Description: 25% REDUCTION - GRAVITY

Repair System Description: 25% REDUCTION - PUMP

Maintenance Agreement Required: ☐ Yes ☑ No

~~Gravel~~ Depth SAND 6" ☐ Slab ☑ Crawl Space ☐ Basement w/plumbing ☐ Basement wo/plumbing

☑ House/Mod. Home No. Bedrooms 3

☐ Mobile Home No. Bathrooms 2

☐ Business No. Employees

☐ Other


Water Supply: ☐ Individual ☑ Public ☐ Community

Comments:/Conditions: INSTALL 25% REDUCTION SYSTEM ON CONTOUR IN FIVE LINES AS FLAGGED

Comments:/Conditions:

SCALE: 1" = 40'

INITIAL SITE SKETCH

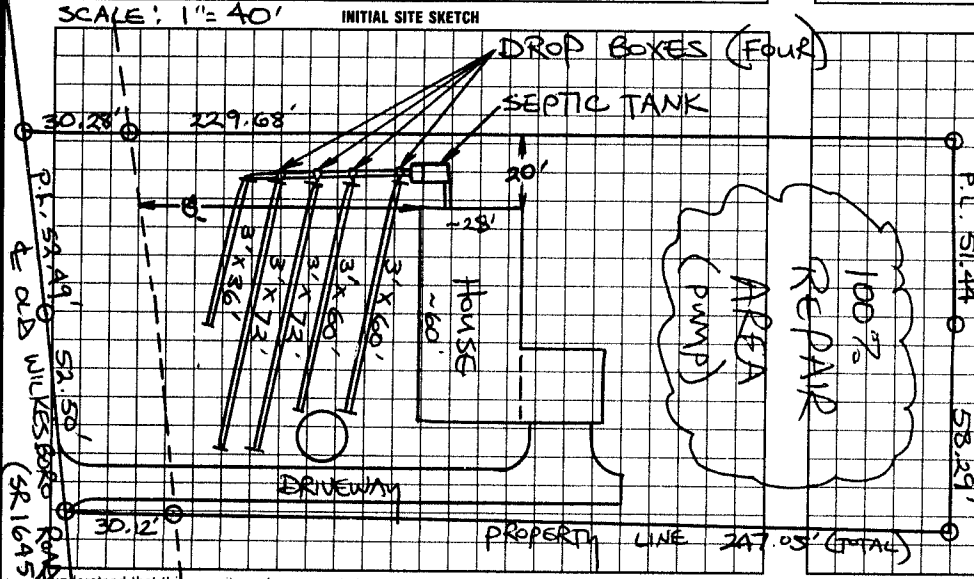

AS BUILT SKETCH

Installed as shown

I understand that this permit can be suspended or revoked if any false information is supplied toward securing the permit/any unauthorized changes are made to the site/any unauthorized changes are made in the installation of the system. Improvement Permit with plat valid without expiration. Improvement Permit with site plan valid for sixty months. Authorization to Construct is valid for a period equal to that of Improvement Permit – not to exceed sixty months.

Signed: Garry L. Austin date 6-16-98 Installed by: Austin Bldgrs

Improvement Permit by: STEVE HEDRICK date 7-10-98 Operation Permit by: Mark C. Austin date 6-22-99

Authorization to Construct by: STEVE HEDRICK date 7-10-98 Existing System Inspection by: date

HEALTH DEPT. COPY: WHITE INSPECTION COPY (FINAL): GREEN OWNER COPY (FINAL): YELLOW INSPECTION COPY (INITIAL): PINK OWNER COPY (INITIAL): GOLD