IREDELL COUNTY HEALTH DEPARTMENT

STATESVILLE 704-878-5305 MOORESVILLE 704-664-5281

IMPROVEMENT PERMIT / AUTHORIZATION TO CONSTRUCT / OPERATION PERMIT / EXISTING SYSTEM INSPECTION

PERMIT# 080477 PIN# 4736 01 1721 DATE 4-21-99

OWNER OR CONTRACTOR DANA ROSEMAN PHONE: Business Home 871-0742

ADDRESS 320 LIPPARD FARM ROAD STATESVILLE, NC 28625

LOCATION NC 115 N, TL SCOTTS CREEK, TR OLD WILKESBORO ROAD, 4TH LOT ON RIGHT

SUBDIVISION BLOCK / SECTION LOT LOT AREA 0.5933 ACRES SITE CLASS PS DESIGN FLOW 360 L.T.A.R. 0.33 GPD/FT²

Septic Tank: 1000 Gallons; STB 1012 Date 11-13-99
Pump Tank: Gallons; PT Date
Pump Make: Model Serial No.
Nitrification Field: No Fields 1 Square Feet Eq. To 1090 Linear Feet 270'
No Lines SEVEN Trench Width 36" Max Trench Bottom Depth 36" Gravel Depth SAND 6"

✓ New System ☐ Repair System Type: I, II, (III), IV, V
System Description: 25% REDUCTION GRAVITY
Repair System Description: 25% REDUCTION PUMP
Maintenance Agreement Required: ☐ Yes ✓ No


✓ House/Mod. Home No. Bedrooms 3
☐ Mobile Home No. Bathrooms 2
☐ Business No. Employees
☐ Other
☐ Slab ✓ Crawl Space ☐ Basement w/plumbing ☐ Basement wo/plumbing

Water Supply: ☐ Individual ✓ Public ☐ Community

Comments/Conditions: INSTALL 25% REDUCTION SYSTEM USING 45" CHAMBERS OR 27 HDS SECTIONS

Comments/Conditions: SEPTIC TANK W/ RISERS INSTALLED USING "POLYLOK" FILTER

INITIAL SITE SKETCH SCALE: 1" = 40'

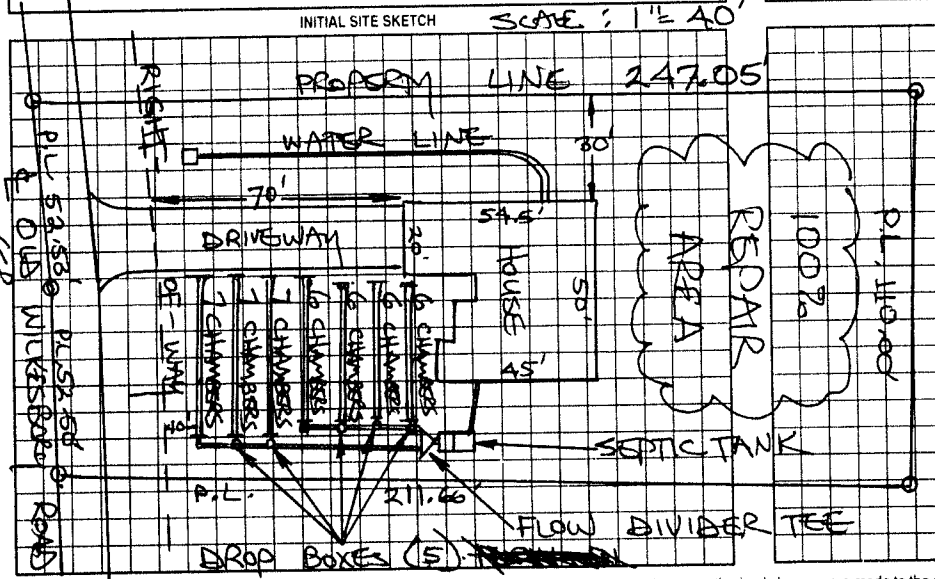

AS BUILT SKETCH

SYSTEM INSTALLED ACCORDING TO INITAL SITE SKETCH

Permit can be suspended or revoked if any false information is supplied toward securing the permit/any unauthorized changes are made to the site/any unauthorized changes are made in the installation of the system. Improvement Permit with plat valid without expiration. Improvement Permit with site plan valid for sixty months. Authorization to Construct is valid for a period equal to that of Improvement Permit – not to exceed sixty months.

Signed: Dana J Roseman date 4/21/99 Installed by: AUSTIN & AUSTIN BUILDERS

Improvement Permit by: STEVE HEDRICK date 4-21-99 Operation Permit by: STEVE HEDRICK date 5-4-00

Authorization to Construct by: STEVE HEDRICK date 4-21-99 Existing System Inspection by: date

HEALTH DEPT COPY WHITE OWNER COPY (FINAL) YELLOW OWNER COPY (INITIAL) PINK