IREDELL COUNTY HEALTH DEPARTMENT

Statesville Phone TR 3-7271 Mooresville Phone NO 3-1271

PERMIT TO INSTALL SEPTIC TANK

Permit NO. 78 Permit Date 8-17 19 72

Owner Henry Ledan Address Stony Point Rt 1

Installed By Alexander Septic Tank Co Address Stony Point


Location of Property Out Hwy 115 to Wilsons 76 Service Station T.L. on Scotts Rd 3rd house on L

Tank		Capacity		Length of Lines		Fixtures	
Block	( )	1000	(✓)	225'	(✓)	No. of Baths	(1)
Precast	(✓)	1250	( )	250'	( )	Dishwasher	( )
		1500	( )	Other		Garbage Grdr.	( )
		Other				Other	

NOTIFY HEALTH DEPARTMENT AT LEAST EIGHT HOURS BEFORE TANK IS TO BE INSPECTED.

Final Inspection 8-17 19 72 Approved (✓) Disapproved ( )

Remarks Well 56' from system

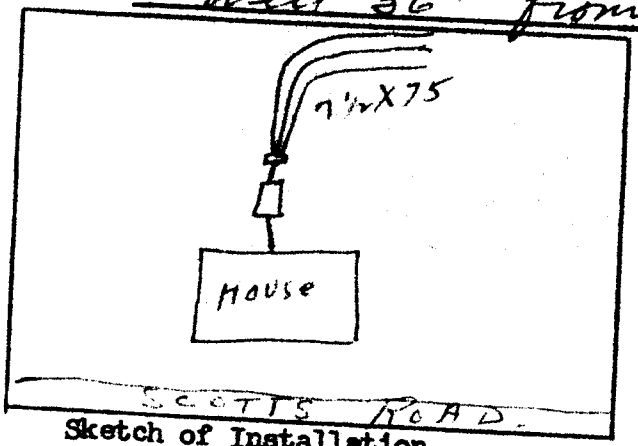

Sketch of Installation

E. G. Stevenson

Sanitarian