IREDELL COUNTY HEALTH DEPARTMENT

Statesville Phone TR 3-7271 — Mooresville Phone NO 3-1271

PERMIT TO INSTALL SEPTIC TANK

Permit No. 305 — Permit Date _____ 19__

Owner George Mahaffey — Address Statesville

Installed By Floyd Adams — Address Taylorsville


Location of Property N. on 115 to Mahaffey development on left. 2nd house on right

Tank		Capacity		Length of Lines		Fixtures	
Block	( )	1000	( )	225'	( )	No. of Baths	(2)
Precast	(✓)	1250	( )	250'	( )	Dishwasher	( )
		1500	( )	Other _____		Garbage Grdr.	( )
		Other _____				Other _____	

NOTIFY HEALTH DEPARTMENT AT LEAST EIGHT HOURS BEFORE TANK IS TO BE INSPECTED.

Final Inspection 5-4-19 71 — Approved (✓) Disapproved ( )

Remarks Basement drain crosses under field about 4' below.

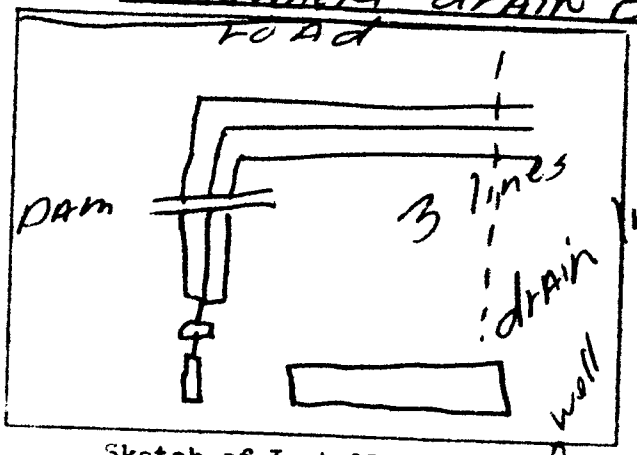

Sketch of Installation

Cress S. Hall

Sanitarian