pd 125 1-23-98

# IREDELL COUNTY HEALTH DEPARTMENT

STATESVILLE 704-878-5305 MOORESVILLE 704-664-5281

## IMPROVEMENT PERMIT / AUTHORIZATION TO CONSTRUCT / OPERATION PERMIT / EXISTING SYSTEM INSPECTION

PERMIT# 70929 PIN# 4736024146 (PT) DATE 1-23-98

OWNER OR CONTRACTOR Todd J. Ellis PHONE: Business Home 878-6633

ADDRESS 178 Meadow Oaks Rd Statesville

LOCATION 115 N TL Scotts Creek Rd on corner of old 115N

SUBDIVISION BLOCK / SECTION LOT LOT AREA 30,037sq' SITE CLASS. PS DESIGN FLOW 480 L.T.A.R. 1.3

Septic Tank: 1500 Gallons; STB 1011 Date 1-3-97

Pump Tank: Gallons; PT Date

Pump Make: Model Serial No.

Nitrification Field: No Fields 1 Square Feet 1200 Linear Feet 400

No Lines 4 Trench Width 36" Max Trench Bottom Depth 36" Gravel Depth N/A

☑ New System ☐ Repair System Type: I, II, III, IV, V, VI

System Description: Gravity Chamber sys HDS

Repair System Description:

Maintenance Agreement Required: ☐ Yes ☐ No


☐ House/Mod. Home ☐ Mobile Home ☐ Business ☑ Other Duplex Apt. House

No. Bedrooms 4 No. Bathrooms 2 No. Employees

☑ Slab ☐ Crawl Space ☐ Basement w/plumbing ☐ Basement wo/plumbing

Water Supply: ☐ Individual ☑ Public ☐ Community

Comments:/Conditions:

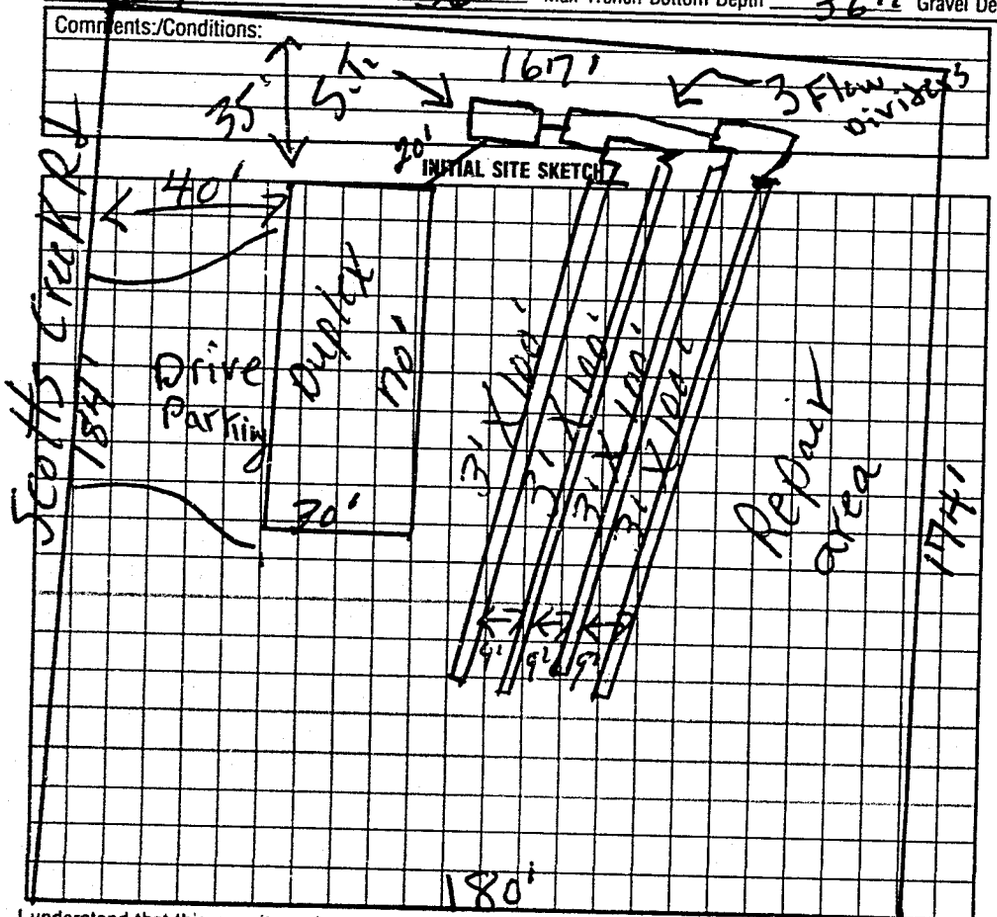


Comments:/Conditions:

AS BUILT SKETCH

Installed as shown

I understand that this permit can be suspended or revoked if any false information is supplied toward securing the permit/any unauthorized changes are made to the site/any unauthorized changes are made in the installation of the system. Improvement Permit with plat valid without expiration. Improvement Permit with site plan valid for sixty months. Authorization to Construct is valid for a period equal to that of Improvement Permit – not to exceed sixty months.

Signed: J Todd Ellis date

Improvement Permit by: L. C. Moore date 1-23-98

Authorization to Construct by: L. C. Moore date 1-23-98

Installed by: David Young

Operation Permit by: Mary C. Orf RS date 4-21-98

Existing System Inspection by: date

HEALTH DEPT. COPY WHITE INSPECTION COPY (FINAL) GREEN OWNER COPY (FINAL) YELLOW INSPECTION COPY (INITIAL) PINK OWNER COPY (INITIAL) GOLD