IREDELL COUNTY HEALTH DEPARTMENT

STATESVILLE 704-878-5305 MOORESVILLE 704-664-5281

IMPROVEMENT PERMIT / AUTHORIZATION TO CONSTRUCT / OPERATION PERMIT / EXISTING SYSTEM INSPECTION

PERMIT# REPAIR PIN# 4736-02-4432 DATE 4-7-05

OWNER OR CONTRACTOR WILLARD L. AUTON PHONE: Business 704-929-0543 Home

ADDRESS 273 GILBERT ROAD STATESVILLE, NC 28677

LOCATION NC 115 NORTH TL SCOTTS CREEK ROAD; 1ST BRICK HOUSE ON RIGHT AT #146

SUBDIVISION BLOCK / SECTION LOT LOT AREA 0.79 ACRE SITE CLASS. PS DESIGN FLOW 360 L.T.A.R. EXISTING 0.3

Septic Tank: EXISTING Gallons; STB Date

Pump Tank: Gallons; PT Date

Pump Make: Model Serial No.

Nitrification Field: No Fields Square Feet 270 Linear Feet 90

No Lines ONE Trench Width 36" Max Trench Bottom Depth 36" +/- Gravel Depth 18"

☐ New System ☑ Repair System Type: I (II), III, IV, V, VI

System Description: CONV, GRAVITY

Repair System Description: CONVENTIONAL, GRAVITY

Maintenance Agreement Required: ☐ Yes ☑ No

☑ House/Mod. Home No. Bedrooms 3

☐ Mobile Home No. Bathrooms

☐ Business No. Employees

☐ Other


☐ Slab ☑ Crawl Space ☐ Basement w/plumbing ☐ Basement wo/plumbing

Water Supply: ☐ Individual ☑ Public ☐ Community

Comments:/Conditions: INSTALL NEW DISTRIBUTION BOX AT LOCATION SHOWN FEEDING NEW 3' x 90' LINE USING 18" STONE

Comments:/Conditions:

INITIAL SITE SKETCH ~ SCALE: 1"=50'

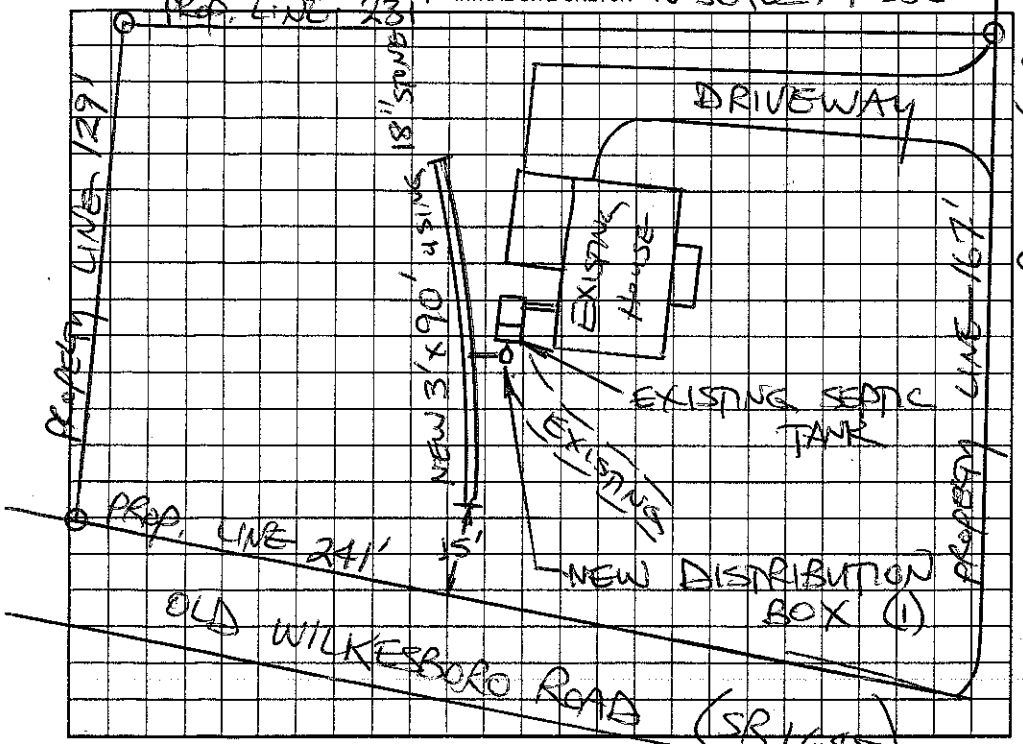

AS BUILT SKETCH

SYSTEM REPAIRED ACCORDING TO INITIAL SITE SKETCH

Permit can be suspended or revoked if any false information is supplied toward securing the permit/any unauthorized changes are made to the site/any unauthorized changes are made in the installation of the system. Improvement Permit with plat valid without expiration. Improvement Permit with site plan valid for sixty months. Authorization to Construct is valid for a period equal to that of Improvement Permit – not to exceed sixty months.

Signed: X Willard L. Auton date 4-7-05

Improvement Permit by: STEVE HEDRICK date 4-7-05

Authorization to Construct by: STEVE HEDRICK date 4-7-05

Installed by: IREDELL BACKHOE

Operation Permit by: STEVE HEDRICK date 4-20-05

Existing System Inspection by: date

HEALTH DEPT. COPY: WHITE OWNER COPY (FINAL): YELLOW OWNER COPY (INITIAL): PINK