IREDELL COUNTY HEALTH DEPARTMENT

Statesville Phone TR 3-7271 Mooresville Phone NO 3-1271

PERMIT TO INSTALL SEPTIC TANK

Permit NO. _____ Permit Date 6-25-1962

Owner Hope Bro. Bldrs. Address 115 N. Rt 2.

Installed By VDE HOKE Address _____


Location of Property On corner 115 N & Fort Dobbs. Rd. across from Marlowes Sta

Tank	Capacity	Length of Lines	Fixtures
Block ( )	800 ( )	150' ( )	No. of Baths (1)
Precast (✓)	900 ( )	175' ( )	Dishwasher ( )
	1000 (✓)	200' ( )	Garbage Grdr. ( )
Rock	1100 ( )	225' (✓)	Auto-Washer (✓)
	1200 ( )	250' ( )	Other _____
	Other _____	Other _____	

NOTIFY HEALTH DEPARTMENT AT LEAST EIGHT HOURS BEFORE TANK IS TO BE INSPECTED.

Final Inspection 6-25 1962 Approved (✓) Disapproved ( )

Remarks Well 50'

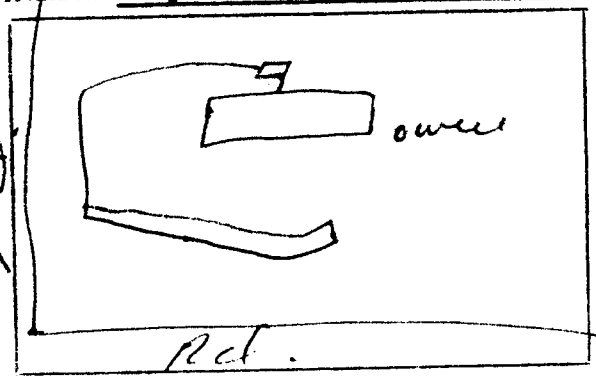

Sketch of Installation

Rud.

Sanitarian