ICHD - ENVIRONMENTAL HEALTH DIVISION

Statesville Office (704) 878-5305 x3456 (MW) Mooresville Office (704) 660-3625

SEPTIC: IMPROVEMENT PERMIT / AUTHORIZATION TO CONSTRUCT / OPERATION PERMIT / EXISTING SYSTEM

PERMIT : OSWP 2024-58565

PIN # 4736 -02 -9001

APPLICANT/OWNER: Jeanie Lentz APPLICANT ADDRESS: 463 Lentz Rd, Statesville

SITE ADDRESS: 2302 Old Wilkesboro Rd, Statesville 28625 PHONE: 980-829-3278 ALT. PHONE -

SITE DIRECTIONS: 115 N - Old Wilkesboro SAP CONTROLLED: ☐ YES ☐ NO

SUBDIVISION: - SECTION: - LOT # - LOT AREA: 0.85 DESIGN FLOW: EX L.T.A.R.(Initial): EX L.T.A.R (Repair): EX

Septic Tank	1000 (gal)	STB	7100	Date		☐ New System	☒ Repair	☐ Expansion	System Type: I (II) III IV V VI
Pump Tank	(gal)	PT		Date		System Description: -			
Pump Make		Model		Serial #		Repair System Description:	Tank Replacement		
# Nitrification Fields	EX	# Lines	EX	Linear Ft	EX	Maintenance Agreement Required:	☐ YES	☒ NO	
Trench Width	EX	*Max. Trench Depth(Initial)	EX	*Max. Trench Depth(Repair)	EX	Gravel Depth	EX	☒ GRAVITY	☐ PRESSURE

* Measured on the downhill side of the trench

Effluent Standard: ☒ DSE ☐ HSE ☐ TS-I ☐ TS-II ☐ RCW ☐ NSF/ANSI 40

Usable Depth to LC (Initial): EX Usable Depth to LC (Repair): EX *Limiting Condition*


☒ Residence ☐ Business ☐ Other ☐ Slab ☐ Basement w/plumbing

No. Bedrooms: EX No. Persons: EX No. Employees: ☒ Crawl Space ☐ Basement w/o plumbing

Water Supply: ☐ Private ☒ Public ☐ Community

Comments / Conditions: Pump, crush, & fill old tank. Replace distribution if necessary.

INITIAL SITE SKETCH

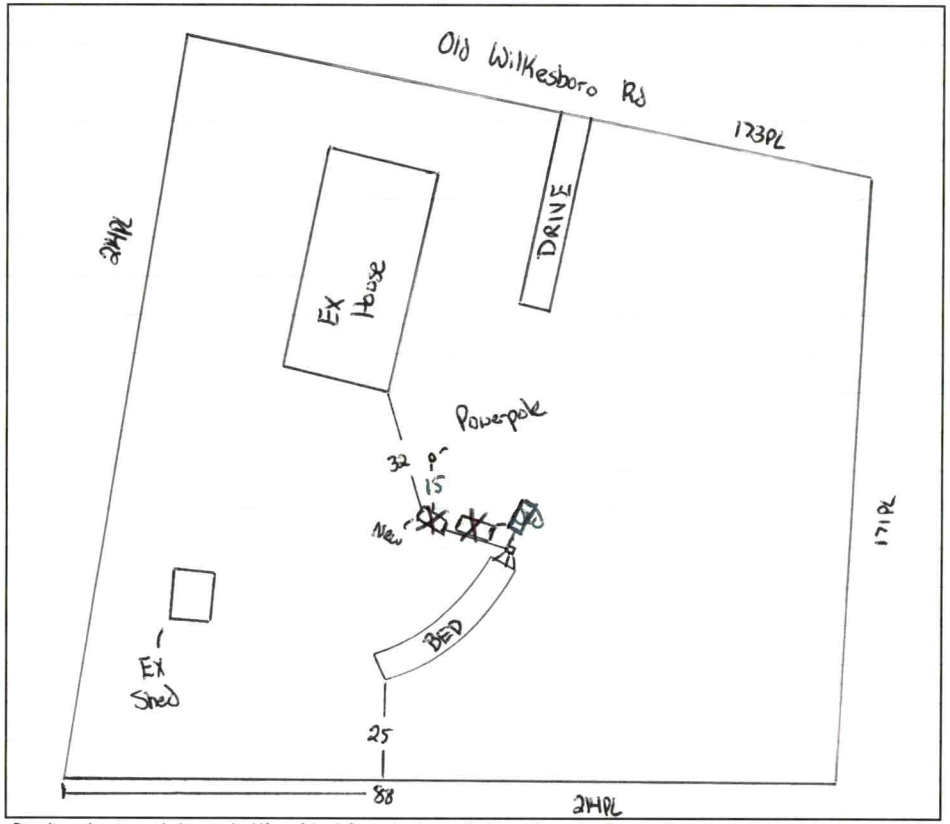

AS BUILT SKETCH

FOR SEPTIC FINAL INSPECTION CALL: 704-664-3703 between 8am-9am the day the inspection is needed. Be sure to speak with an inspector to confirm your time.

Installed as Drawn

Permit can be suspended or revoked if any false information is supplied toward securing the permit / any unauthorized changes are made to the site / any unauthorized changes are made in the installation of the system. **CONTACT A LOCATOR SERVICE PRIOR TO ANY EXCAVATION**

☐ **IMPROVEMENT PERMIT** ***with plat*** *valid without expiration.* ☒ **IMPROVEMENT PERMIT** ***with site plan*** *valid for 60 mos.* ☒ **AUTHORIZATION TO CONSTRUCT** *valid for period equal to IMPROVEMENT PERMIT--not to exceed 60 mo.*

Owner / Applicant Signature: Online Signature Date: -

IMPROVEMENT PERMIT by: Cory Whit Date: 7/30/24

AUTHORIZATION TO CONSTRUCT by: Cory Whit Date: 7/30/24

Installed by: Lentz

OPERATION PERMIT by: Cory Whit Date: 8/6/24

Existing System Inspected by: Date:

Item	Date	Initials
Drain Lines Checked		
Tanks Checked		
Pressure Manifold or Valve Box Checked		
Pressure Head Set		
Electrical Checked		
Floats Set		
Alarm Checked		
Maintenance Contract Needed? Y / N		
Comments:		

Repairs Only	
	State Code
Failing System Code	
Type of Distribution	G or P
Type of Failure/Malfunction	
Primary Cause of Failure/Malfunction	
Age of System? _____	
Initial or Repair? _____	

PERMIT SNAPSHOT REPORT OSWP-2024-58565 FOR IREDELL COUNTY

Permit Type	Environmental Health OSWP	**Project:**		**App Date:**	07/26/2024
Work Class:	EH Septic Permit	**District:**	Iredell County	**Exp Date:**	NOT AVAILABLE
Status:	PRIORITY PERMIT	**Square Feet:**	0.00	**Completed:**	NOT COMPLETED
Valuation:	$0.00	**Assigned To:**	Whicker, Cory	**Approval Expire Date:**	
Description:	Septic tank has collapsed.				

Parcel: 4736025601.000 Main	**Address:** 2302 Old Wilkesboro Rd Statesville, NC 28625 Main	**Zone:** RA(Residential Agricultural District)

Applicant/Authorized Agent	Property Owner	Applicant/Authorized Agent
Jeanie Lentz	Rex Henderson	Jeanie Lentz
Home: (980) 829-3278	Home: (704) 677-4108	463 Lentz Road
		Statesville, NC 28625

Permit Custom Fields

How is your site plan being submitted	Custom Site Plan	Septic Application/Permit Type	Repair	Does the site contain any jurisdictional wetlands	No
Non-domestic Sewage Generated	No	Other Public Agency	No	All proposed structure dimensions	N/A
What are the proposed structures	Other Addition/Structure	Maximum Number of Bedrooms	2	If other Addition/Structure, please explain	
Number of Occupants	2	Foundation Type	Crawl Space Foundation	Water Supply	Other Public Water
Desired Septic System Type	No Preference	If other septic system type, please explain		Pump Make	
# of Nitrification Fields		Model		Serial #	
System Description		Repair System Description		Comments/Conditions	
Permit type(s)	Authorization to Construct	Additional Unique Setbacks Apply	No		

Attachment File Name	Added On	Added By	Attachment Group	Notes
Signature_Jeanie_Lentz_7/26/2024.jpg	07/26/2024 16:24	Lentz, Jeanie		Uploaded via CSS
2302 Old Wilkesboro Hwy AC Form_v1.pdf	07/26/2024 16:29	Lentz, Jeanie	Available Online	
2302 Old Wilkesboro Hwy Site Plan_v1.pdf	07/26/2024 16:29	Lentz, Jeanie	Available Online	
6347EB13-E0D3-4A66-A02E-DADD0C124A2E_v1.pdf	07/26/2024 16:30	Lentz, Jeanie	Available Online	

Workflow Step / Action Name	Action Type	Start Date	End Date
Application Completeness Check v.1		07/26/2024 16:30	07/26/2024 16:32
Confirm application complete v.1	Generic Action		07/26/2024 16:32
Lot Readiness Verification v.1			
~~OSWP Septic Preliminary Site Visit v.1~~	Inspection		07/26/2024 16:31
OSWP Site Evaluation v.1	Inspection		
~~**Zoning Review v.1**~~			07/26/2024 16:31
~~Floodplain Admin Overview v.1~~	Task		07/26/2024 16:31
~~Issue Invoice v.1~~	Generic Action		07/26/2024 16:31
~~Fees Paid v.1~~	Generic Action		07/26/2024 16:31
Fees v.1			
Issue Invoice v.1	Generic Action		