7/2 Pd 300.00

IREDELL COUNTY HEALTH DEPARTMENT

STATESVILLE 704-878-5305 MOORESVILLE 704-664-5281

IMPROVEMENT PERMIT / AUTHORIZATION TO CONSTRUCT / OPERATION PERMIT / EXISTING SYSTEM INSPECTION

PERMIT# 092271 PIN# 4736 02 8439 DATE 6-18-01

OWNER OR CONTRACTOR RANDY HELLMAN - WESTWOOD BAPTIST PHONE: Business Home 704-878-6484

ADDRESS 136 Wildwood RANCH RD, STATESVILLE, NC 28625

LOCATION 115 PAST SCOTTS CRK, ON LEFT

SUBDIVISION BLOCK / SECTION LOT LOT AREA 4.53 SITE CLASS. PS DESIGN FLOW [redacted]975 L.T.A.R. 0.33 GPD/FT²

Septic Tank: 1500/1000 Gallons: STB 312 Date 4-29-a
Pump Tank: Gallons: PT Date
Pump Make: Model Serial No
Nitrification Field: No Fields 1 Square Feet EQ to 2880 Linear Feet 720 +
No Lines 6 Trench Width 36" Max Trench Bottom Depth 36" Gravel Depth N/A

[X] New System [ ] Repair System Type: I, II, (III), IV, V, VI
System Description: CONV CHAMBERS
Repair System Description: PUMP/GRAV CHAMBERS
Maintenance Agreement Required: [ ] Yes [X] No

[ ] House/Mod. Home No. Bedrooms
[ ] Mobile Home No. Bathrooms 1
[ ] Business No. Employees 30
[X] Other SUNDAY SCHOOL ETC...


[ ] Slab [X] Crawl Space [ ] Basement w/plumbing [ ] Basement wo/plumbing

Water Supply: [ ] Individual [X] Public [ ] Community


Comments/Conditions:
1. SET NEW 1500 GAL TANK OR 1000 GAL
2. PUT 2 CLEANOUTS IN SYSTEM
3. INSTALL NEW SUPPLY LINE TO MAINTAIN 5' OFF FOUNDATION

Comments/Conditions: 2 6x6 Filter
Septic Tank marker

INITIAL SITE SKETCH

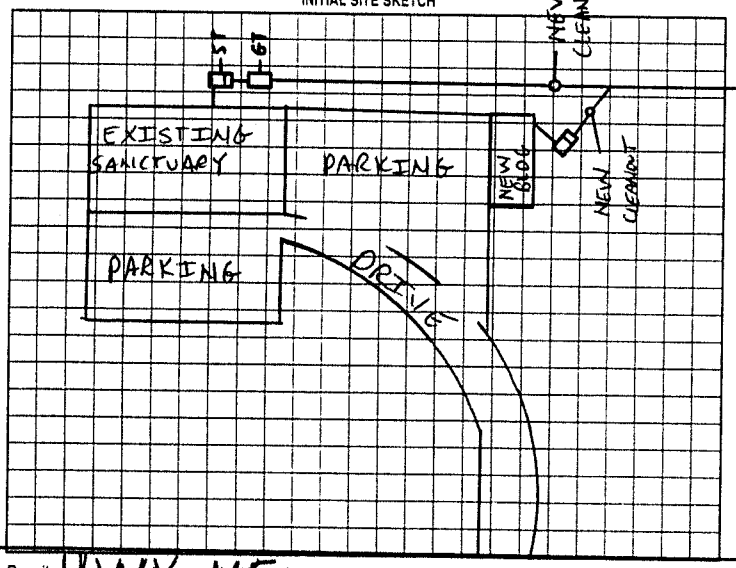

AS BUILT SKETCH

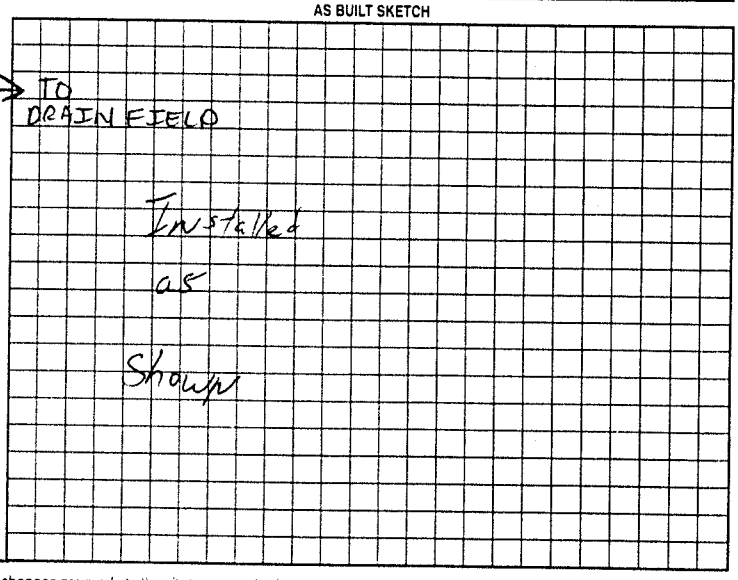

HWY 115

Permit can be suspended or revoked if any false information is supplied toward securing the permit/any unauthorized changes are made to the site/any unauthorized changes are made in the installation of the system. Improvement Permit with plan valid without expiration. Improvement Permit with site plan valid for sixty months. Authorization to Construct is valid for a period equal to that of Improvement Permit – not to exceed sixty months.

Signed: [signature] date 7/2/01 Installed by: Tommy Frye

Improvement Permit by: [signature] REHS date 6-18-01 Operation Permit by: William O. Johnson date 7/3/01

Authorization to Construct by: [signature] REHS date 6-18-01 Existing System Inspection by: date

HEALTH DEPT COPY: WHITE OWNER COPY (FINAL): YELLOW OWNER COPY (INITIAL): PINK