IREDELL COUNTY HEALTH DEPARTMENT

STATESVILLE 704-878-5305 MOORESVILLE 704-664-5281

IMPROVEMENT PERMIT / CERTIFICATE OF COMPLETION / OPERATION PERMIT / EXISTING SYSTEM INSPECTION

PROPERTY DESCRIPTION NO. 24796 DATE 9-20-96 TAX MAP NO. 9A- A-42 (PART) Watershed: ☐ Yes ☒ No

OWNER OR CONTRACTOR WESTWOOD BAPTIST PHONE: Business Home 871-1110

ADDRESS P.O. BOX 6508, STATESVILLE, NC. 28687

LOCATION NC 115 NORTH, ~400 FEET ON LEFT PAST SCOTTS CREEK ROAD

SUBDIVISION BLOCK / SECTION LOT LOT AREA 4.5285 ACRES SITE CLASS. PS DESIGN FLOW 975 L.T.A.R. 0.33 GPD/FT²

Septic Tank: 1640 (+) Gallons; STB Date

~~Grease~~ Septic Tank: 1082 (+) Gallons; PT Date

Pump Make: Model Serial No.

Nitrification Field: No Fields 1 Square Feet 60 TO 2880 Linear Feet 720+

No Lines SIX Trench Width 36" Max Trench Bottom Depth 36" Gravel Depth N/A

☒ New System ☐ Repair System Type: I, II, (III), IV, V, VI

System Description: CHAMBERED GRAVITY

Repair System Description: CHAMBERED PUMP

Maintenance Agreement Required: ☐ Yes ☒ No

☐ House/Mod. Home No. Bedrooms

☐ Mobile Home No. Bathrooms 5

☐ Business No. Employees

☒ Other CHURCH W/195 SEATS


☒ Slab ☐ Crawl Space ☐ Basement w/plumbing ☐ Basement wo/plumbing

Water Supply: ☐ Individual ☐ Community ☒ Public


Comments: ① CONTACT HEALTH DEPT AFTER CLEARING & PRIOR TO INSTALLATION TO FLAG OUT SYSTEM ② INSTALL 120 CHAMBERS IN SIX EQUAL LENGTH LINES AS SHOWN.

Comments:

INITIAL SITE SKETCH

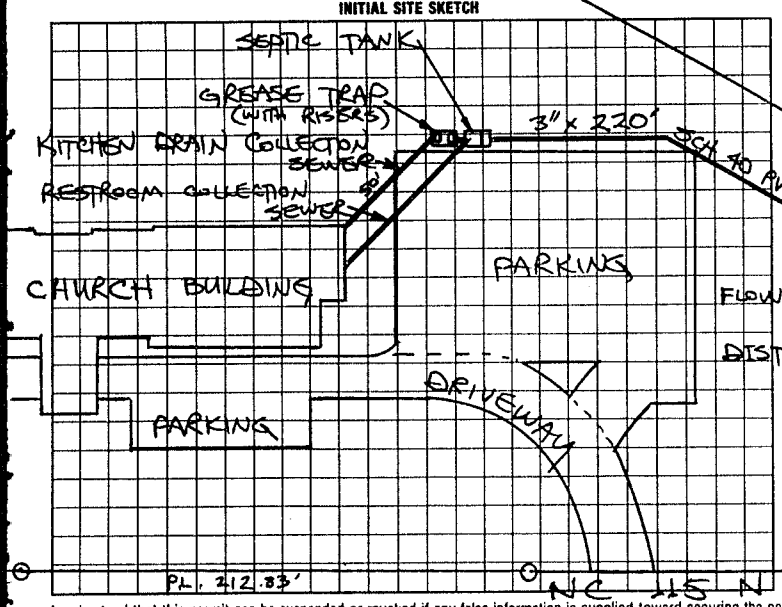

AS BUILT SKETCH

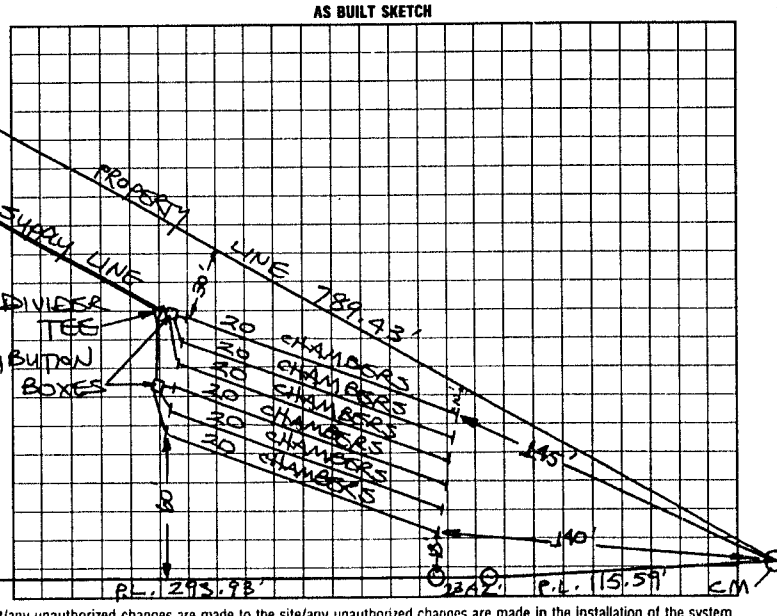

I understand that this permit can be suspended or revoked if any false information is supplied toward securing the permit/any unauthorized changes are made to the site/any unauthorized changes are made in the installation of the system. AUTH. TO CONST. IS VALID FOR A PERIOD EQUAL TO THE VALIDITY OF THE IP NOT TO EXCEED FIVE YEARS. IP WITH SITE PLAN IS VALID FIVE YEARS.

Signed: Installed by:

Improvement Permit by: STEVE HEDRICK date 9-20-96 ~~Certificate of Completion by:~~ date

AUTHORIZATION TO CONSTRUCT ~~Existing System Inspection~~ by: STEVE HEDRICK date 9-20-96 Operation Permit by: date

HEALTH DEPT. COPY: WHITE INSPECTION COPY (FINAL): GREEN OWNER COPY (FINAL): YELLOW INSPECTION COPY (INITIAL): PINK OWNER COPY (INITIAL): GOLD