IREDELL COUNTY HEALTH DEPARTMENT

STATESVILLE 704-878-5305 MOORESVILLE 704-664-5281

IMPROVEMENT PERMIT / AUTHORIZATION TO CONSTRUCT / OPERATION PERMIT / EXISTING SYSTEM INSPECTION

PERMIT# 103529 PIN# 4736-03-4320 DATE 1/22/02

OWNER OR CONTRACTOR Pat Dean Henderson, Sr PHONE: Business — Home (704) 873-8150

ADDRESS 2331 Old Wilkesboro Rd, Statesville, N.C. 28677

LOCATION Hwy 115 N, @ Scotts Creek Rd, @ old Wilkesboro Hwy, on Left beside 1st brick House on Left.

SUBDIVISION — BLOCK / SECTION — LOT — LOT AREA 1.88 Ac. SITE CLASS PS DESIGN FLOW — L.T.A.R. —

Septic Tank: 1000 Gal. Gallons: STB — Date —

Pump Tank: — Gallons: PT — Date —

Pump Make: — Model — Serial No. —

Nitrification Field: No Fields 1 Square Feet 720 Linear Feet 240

No Lines 2 Trench Width — Max Trench Bottom Depth — Gravel Depth 12"

☐ New System ☐ Repair System Type: I, II, III, IV, V, VI

System Description: Gravity, Conventional

Repair System Description: —

Maintenance Agreement Required: ☐ Yes ☐ No

☐ Slab ☒ Crawl Space ☐ Basement w/plumbing ☐ Basement wo/plumbing

☐ House/Mod. Home ☒ Mobile Home ☐ Business ☐ Other

No. Bedrooms 3 No. Bathrooms 2 No. Employees —

Water Supply: ☐ Individual ☒ Public ☐ Community

Comments:/Conditions:


Comments /Conditions.

Existing System Okay at Time of Inspection.

INITIAL SITE SKETCH

AS BUILT SKETCH

Not to Scale

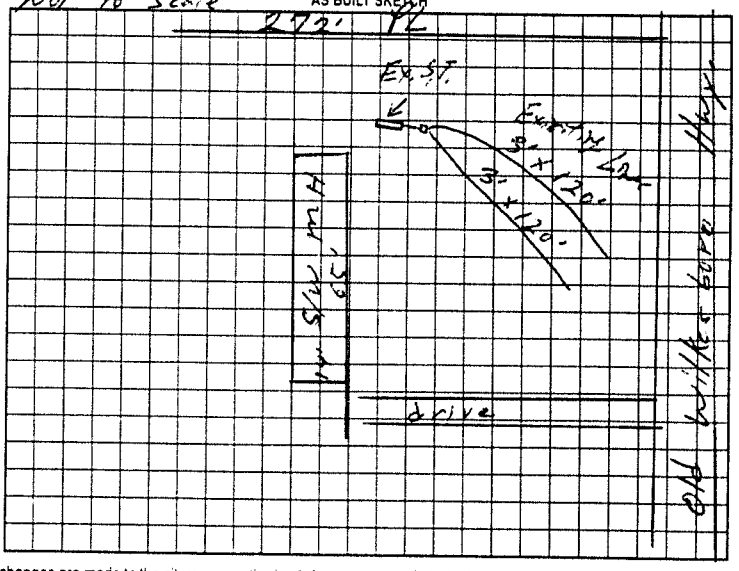

Permit can be suspended or revoked if any false information is supplied toward securing the permit/any unauthorized changes are made to the site/any unauthorized changes are made in the installation of the system. Improvement Permit with plat valid without expiration. Improvement Permit with site plan valid for sixty months. Authorization to Construct is valid for a period equal to that of Improvement Permit – not to exceed sixty months.

Signed: [signature] date 1-22-2002 Installed by: —

Improvement Permit by: — date — Operation Permit by: — date —

Authorization to Construct by: — date — Existing System Inspection by: William O. Johnson date 1/22/02

HEALTH DEPT. COPY: WHITE OWNER COPY (FINAL): YELLOW OWNER COPY (INITIAL): PINK