IREDELL COUNTY HEALTH DEPARTMENT - *ENVIRONMENTAL HEALTH* ☑ STATESVILLE OFFICE 704-878-5305 ☐ MOORESVILLE OFFICE 704-664-5281

IMPROVEMENT PERMIT / AUTHORIZATION TO CONSTRUCT / OPERATION PERMIT / EXISTING SYSTEM INSPECTION

PERMIT # 173856 PIN # 4736-03-8896 DATE July 24, 2012

OWNER Douglas Hunt APPLICANT: Same PHONE: Home/Cell # 704.871.1997 Business # 704-302-0980

SITE ADDRESS 118 Pearce Farm Lane OWNER / APPLICANT ADDRESS 118 Pearce Farm Lane, Statesville 28625

SITE DIRECTIONS NC 115 North, R Pearce Farm Lane, on Left at #118

SUBDIVISION BLOCK / SECTION LOT # LOT AREA 1.065 AC DESIGN FLOW 360 L.T.A.R. Existing

Septic Tank 1000 Gallons: STB Date

Pump Tank Gallons: PT Date

Pump Make Model Serial #

No. Nitrification Fields: 1 No. Lines BED Linear Feet EX (75')

Trench Width BED Max. Trench Bottom Depth EX

☐ New System ☐ Repair ☐ Expansion System Type I II III IV V VI

System Description: Conventional, Gravity

Repair System Description:

Maintenance Agreement Required ☐ YES ☑ NO

Gravel Depth EX ☑ GRAVITY ☐ PRESSURE

☑ Residence No. Bedrooms 3

☐ Business No. Persons

☐ Other No. Employees

☐ Slab ☐ Crawl Space

☐ Basement w/plumbing ☐ Basement w/o plumbing


Water Supply: ☑ Private Well ☐ Public ☐ Community

Comments / Conditions

Keep building foundation minimum five feet from system

INITIAL SITE SKETCH

AS BUILT SKETCH

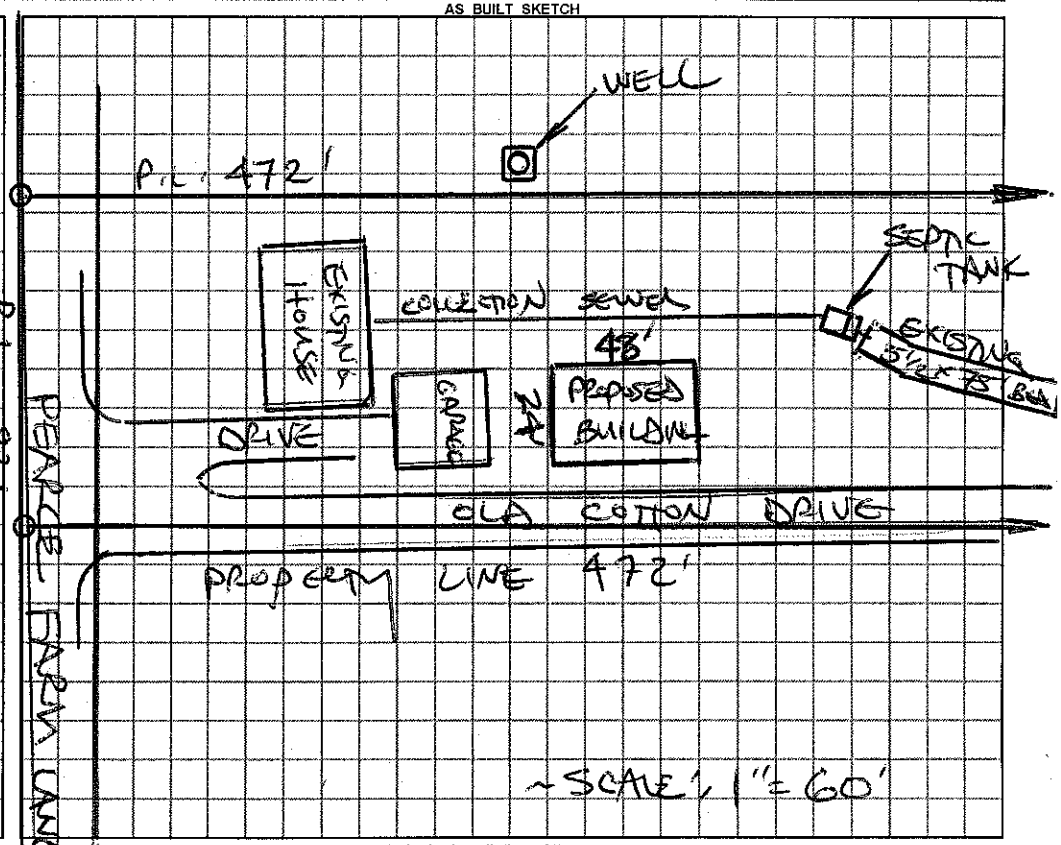

Permit can be suspended or revoked if any false information is supplied toward securing the permit / any unauthorized changes are made to the site / any unauthorized changes are made in the installation of the system.

☐ ***IMPROVEMENT PERMIT*** *with plat valid without expiration.* ☐ ***IMPROVEMENT PERMIT*** *with ~~plat valid without expiration.~~ site plan valid 60 mo.* ☐ ***AUTHORIZATION TO CONSTRUCT*** valid for period equal to IMPROVEMENT PERMIT--not to exceed 60 mo.

Owner / Applicant Signature: Date

IMPROVEMENT PERMIT by: REHS Date

AUTHORIZATION TO CONSTRUCT by: REHS Date

YOU SHOULD CONTACT A LOCATOR SERVICE PRIOR TO ANY EXCAVATION

Installed by:

OPERATION PERMIT by: REHS Date

Existing System Inspected by: Steve Hedrick REHS Date 7/24/2012

White Copy – Environmental Health YELLOW COPY (Final) Owner / Applicant PINK COPY (Initial) Owner / Applicant