IREDELL COUNTY HEALTH DEPARTMENT

STATESVILLE 704-878-5305 MOORESVILLE 704-664-5281

IMPROVEMENT PERMIT / CERTIFICATE OF COMPLETION / OPERATION PERMIT / EXISTING SYSTEM INSPECTION

PROPERTY DESCRIPTION NO. REPAIR DATE 3-26-96 TAX MAP NO. Watershed: Yes (NO)

OWNER OR CONTRACTOR ALLEN UPRIGHT PHONE: Business Home 872-0806

ADDRESS 2143 WILKESBORO HWY, STATESVILLE, NC 28677

LOCATION NC115N, HOUSE ON LEFT 3RD BEFORE EVENBURG ROAD

SUBDIVISION BLOCK / SECTION LOT LOT AREA AMPLE SITE CLASS P5 DESIGN FLOW 360 L.T.A.R. EXISTING

Septic Tank: EXISTING Gallons: STB Date

Pump Tank: Gallons: PT Date

Pump Make: Model Serial No.

Nitrification Field: No Fields 1 Square Feet 270 Linear Feet 90

No Lines 1 Trench Width 36" Max Trench Bottom Depth 36" Gravel Depth 24"

☐ New System ☑ Repair System Type: I (II) III IV V VI

System Description:

Repair System Description: CONVENTIONAL GRAVITY

Maintenance Agreement Required: Yes ☑ No

☐ Slab ☐ Crawl Space ☐ Basement w/plumbing ☐ Basement wo/plumbing

☑ House/Mod. Home No. Bedrooms 3

☐ Mobile Home No. Bathrooms 2

☐ Business No. Employees


☐ Other

Water Supply:
☑ Individual
☐ Community
☐ Public
WELL

Comments: ① INSTALL NEW DROP BOX AT LOCATION SHOWN ② INSTALL NEW 3" x 90' LINE ON CONTOUR AS SHOWN USING 24" STONE

Comments:

INITIAL SITE SKETCH

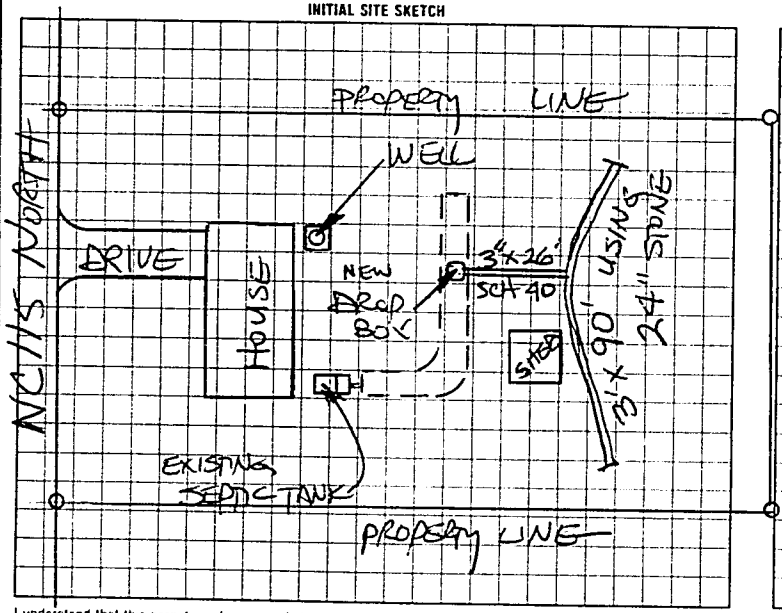

AS BUILT SKETCH

SYSTEM REPAIRED ACCORDING TO INITAL SITE SKETCH

I understand that this permit can be suspended or revoked if any false information is supplied toward securing the permit/any unauthorized changes are made to the site/any unauthorized changes are made in the installation of the system. Authorization to Construct is valid five (5) years from date of issuance. Improvement Permit has no expiration date.

Signed A. Allen Upright

Improvement Permit by: STEVE HENDRICK date 3-26-96

Existing System Inspection by: STEVE HENDRICK date 3-26-96

AUTHORIZATION TO CONSTRUCT:

Installed by: JAMES HYDER

Certificate of Completion by: date

Operation Permit by: STEVE HENDRICK date 4-8-96

HEALTH DEPT COPY WHITE | INSPECTION COPY (FINAL) GREEN | OWNER COPY (FINAL) YELLOW | INSPECTION COPY (INITIAL) PINK