IREDELL COUNTY HEALTH DEPARTMENT

STATESVILLE 704-878-5305 MOORESVILLE 704-664-5281

IMPROVEMENT PERMIT / CERTIFICATE OF COMPLETION / OPERATION PERMIT / EXISTING SYSTEM INSPECTION

PROPERTY DESCRIPTION NO. REPAIR DATE 4/20/95 TAX MAP NO.

OWNER OR CONTRACTOR JACKIE LEE HENRY PHONE: Business Home 873-6853

ADDRESS 2149 WILKESBORO HIGHWAY, STATESVILLE, NC 28677 Watershed: ☐ Yes ☑ No

LOCATION NC 115N, 4TH HOUSE ON LEFT PAST LIFE MOUNTAIN (BLANKENSHIP)

SUBDIVISION BLOCK / SECTION LOT LOT AREA LIMITED SITE CLASS. PS DESIGN FLOW 360 L.T.A.R. EXISTING

Septic Tank: EXISTING Gallons: STB Date

Pump Tank: Gallons: PT Date

Pump Make: Model Serial No.

Nitrification Field: No Fields 1 Square Feet 450 Linear Feet 75'

No Lines 1 BED Trench Width 6 FEET Max Trench Bottom Depth 36" Gravel Depth 24"

☐ New System ☑ Repair System Type: I II III IV V VI

System Description: CONVENTIONAL GRAVITY

Repair System Description: CONV. GRAVITY

Maintenance Agreement Required ☐ Yes ☑ No

☑ House/Mod. Home No. Bedrooms 3

☐ Mobile Home No. Bathrooms 2

☐ Business No. Employees

☐ Other


☐ Slab ☐ Crawl Space ☑ Basement w/plumbing ☐ Basement wo/plumbing

Water Supply: ☑ Individual ☐ Community ☐ Public WELL

Comments: ① CHECK TANK FOR INTEGRITY, INSTALL NEW SANITARY TEE IF NECESSARY ② INSTALL NEW DISTRIBUTION BOX ③ INSTL NEW 6' X 75' BED USING 24" STONE

Comments:

INITIAL SITE SKETCH

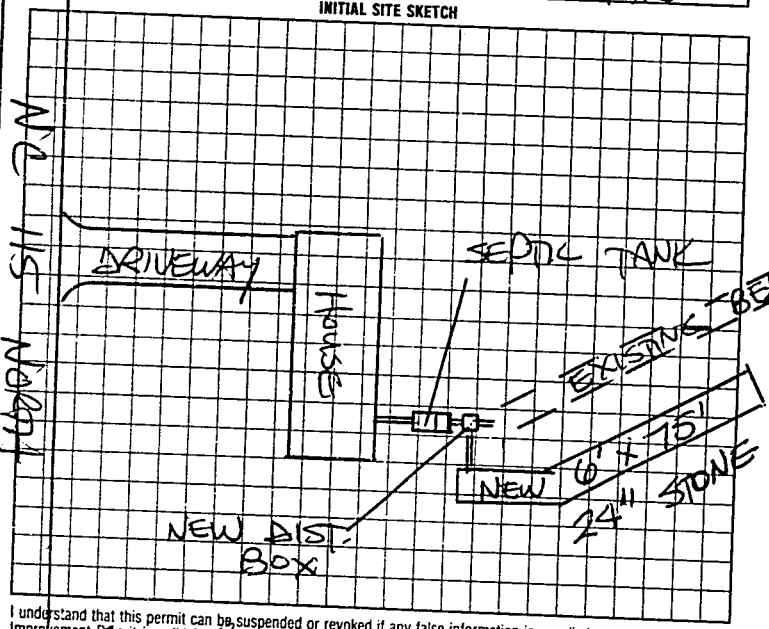

AS BUILT SKETCH

SYSTEM REPAIRED ACCORDING TO INITIAL SITE SKETCH

I understand that this permit can be suspended or revoked if any false information is supplied toward securing the permit/any unauthorized changes are made to the site/any unauthorized changes are made in the installation of the system. Improvement Permit is valid for 60 months from date of issuance.

Signed: Jackie Lee Henry

Improvement Permit by: STEVE HEDRICK date 4/20/95

Existing System Inspection by: date

Installed by: JEFF HURLBUT

Certificate of Completion by: STEVE HEDRICK date 4/27/95

Operation Permit by: date

HEALTH DEPT. COPY: WHITE INSPECTION COPY (FINAL): GREEN OWNER COPY (FINAL): YELLOW INSPECTION COPY (INITIAL): PINK OWNER COPY (INITIAL): GOLD