IREDELL COUNTY HEALTH DEPARTMENT - *ENVIRONMENTAL HEALTH* ☒ STATESVILLE OFFICE 704-878-5305 ☐ MOORESVILLE OFFICE 704-664-5281

IMPROVEMENT PERMIT / AUTHORIZATION TO CONSTRUCT / OPERATION PERMIT / EXISTING SYSTEM INSPECTION (1)

PERMIT # 168027 PIN # 4736-11-0175 DATE 8-29-11

OWNER Farrell McKinney APPLICANT:

SITE ADDRESS 121 Ellenburg Rd PHONE: Home/Cell # 704 924 7080 Business #

SITE DIRECTIONS 21N, (L) Fort Dobbs, (R) Chipley Ford (L) Sullivan Farm Rd.; (L) 115, (R) Ellenburg Dr.; 1st house on left OWNER / APPLICANT ADDRESS 121 Ellenburg Rd.

SUBDIVISION Woodside Park BLOCK / SECTION LOT # 5 LOT AREA DESIGN FLOW 360 L.T.A.R. Ex

Septic Tank 1000 Gallons: STB Date

Pump Tank Gallons: P T Date

Pump Make Model Serial #

No. Nitrification Fields: ex No. Lines ex Linear Feet ex

Trench Width ex Max. Trench Bottom Depth ex Gravel Depth ex

☐ New System ☐ Repair ☐ Expansion System Type I II III IV V VI

System Description: existing

Repair System Description:

Maintenance Agreement Required ☐ YES ☐ NO

☒ GRAVITY ☐ PRESSURE

☒ Residence No. Bedrooms 3

☐ Business No. Persons

☐ Other No. Employees


☐ Slab ☐ Crawl Space

☒ Basement w/plumbing ☐ Basement w/o plumbing


Water Supply: ☐ Private ☒ Public ☐ Community

Comments / Conditions

INITIAL SITE SKETCH

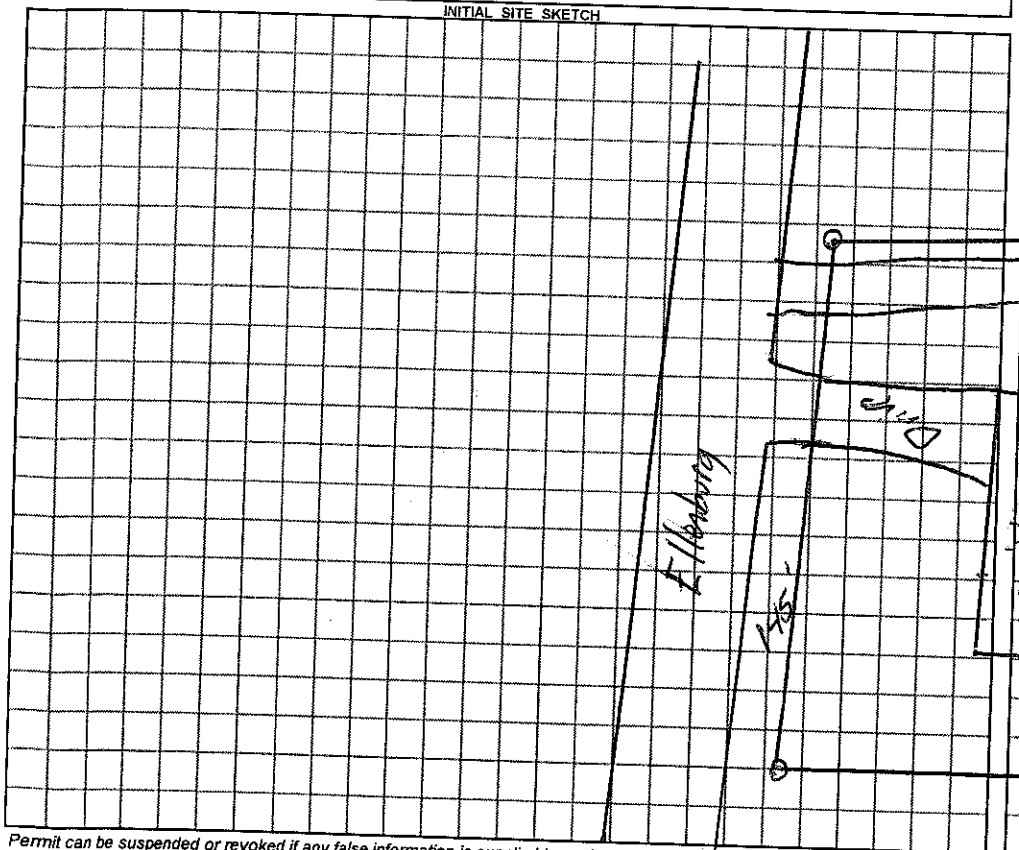

AS BUILT SKETCH

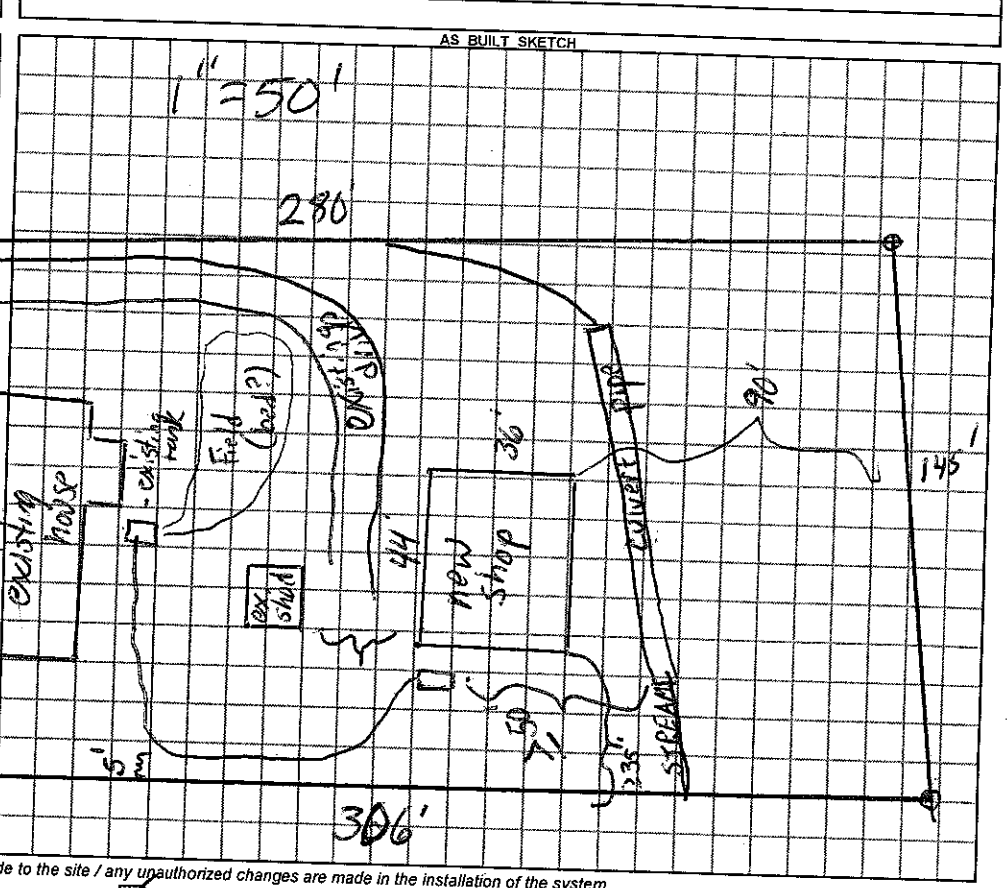

Permit can be suspended or revoked if any false information is supplied toward securing the permit / any unauthorized changes are made to the site / any unauthorized changes are made in the installation of the system.

☐ ***IMPROVEMENT PERMIT*** with plat valid without expiration ☒ ***IMPROVEMENT PERMIT*** with plat valid without expiration, site plan valid 60 mos. ☒ ***AUTHORIZATION TO CONSTRUCT*** valid for period equal to IMPROVEMENT PERMIT--not to exceed 60 mo.

Owner / Applicant Signature: Farrell McKinney Date 8/29/11 Installed by:

IMPROVEMENT PERMIT by: REHS Date OPERATION PERMIT by: REHS Date

AUTHORIZATION TO CONSTRUCT by: REHS Date Existing System Inspected by: REHS Date 8-29-11

YOU SHOULD CONTACT A LOCATOR SERVICE PRIOR TO ANY EXCAVATION

White Copy – Environmental Health YELLOW COPY (Final) Owner / Applicant PINK COPY (Initial) Owner / Applicant