IREDELL COUNTY HEALTH DEPARTMENT

Statesville Phone TR 3-7271 Mooresville Phone NO 3-1271

PERMIT TO INSTALL SEPTIC TANK

Permit NO. _____ Permit Date 12 1961

Owner Mr. Billy Lucas Address Rt 8 Statesville

Installed By Ray T Luft Address Statesville


Location of Property Take 115 to the Scott Rd Exit Right just opposite Scott Rd. 5th House Right

Tank		Capacity		Length of Lines		Fixtures	
Block	(✓)	800	( )	150'	( )	No. of Baths	(✓)
Precast	( )	900	( )	175'	( )	Dishwasher	( )
		1000	(✓)	200'	( )	Garbage Grdr.	( )
		1100	( )	225'	(✓)	Auto-Washer	( )
		1200	( )	250'	( )	Other	( )
		Other		Other			

NOTIFY HEALTH DEPARTMENT AT LEAST EIGHT HOURS BEFORE TANK IS TO BE INSPECTED.

Final Inspection 12 1961 Approved (✓) Disapproved ( )

Remarks

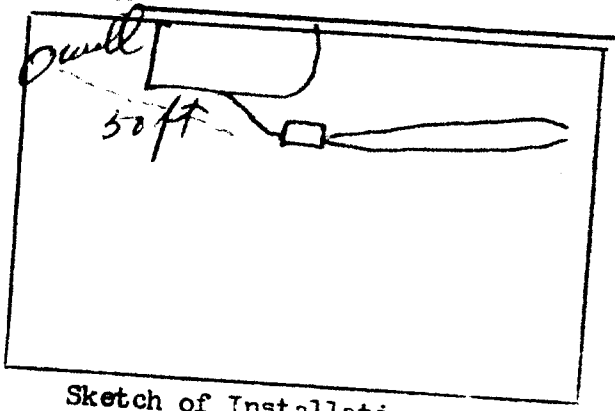

Sketch of Installation

Sanitarian