IREDELL COUNTY HEALTH DEPARTMENT

STATESVILLE 704-878-5305 CI MOORESVILLE 704-664-5281

IMPROVEMENT PERMIT / AUTHORIZATION TO CONSTRUCT / OPERATION PERMIT / EXISTING SYSTEM INSPECTION

PERMIT# 110333 PIN# 4736-13-0357 DATE 1-02-03

OWNER OR CONTRACTOR LIVING WATER ASSEMBLY of GOD PHONE: Business 704-878-6957 Home

ADDRESS 2268 WILKESBORO HWY, STATESVILLE, NC 28625

LOCATION NC 115 NORTH, ON RIGHT AT BOX # 2268

SUBDIVISION BLOCK / SECTION LOT LOT AREA 1.8586 (TOTAL) Acres SITE CLASS. PS DESIGN FLOW 540 L.T.A.R. 0.30 GPD/FT²

Septic Tank: 1500 Gallons; STB 10' Date 10-27-02

Pump Tank: Gallons; PT Date

Pump Make: Model Serial No.

Nitrification Field: No Fields 1 Square Feet 60,70 1800 Linear Feet 450

No Lines FIVE Trench Width 36" Max Trench Bottom Depth 36" Gravel Depth 12"

☐ New System ☐ Repair System Type: I, II, III, IV, V, VI

System Description: 25% REDUCTION, GRAVITY

Repair System Description: 25% REDUCTION, GRAVITY

Maintenance Agreement Required: ☐ Yes ☒ No

☐ House/Mod. Home No. Bedrooms

☐ Mobile Home No. Bathrooms 3

☐ Business No. Employees

☒ Other CHURCH @ 180 SEATS @ 3 GPD/SEAT


☐ Slab ☐ Crawl Space ☐ Basement w/plumbing ☐ Basement wo/plumbing

Water Supply: ☐ Individual ☒ Public ☐ Community


Comments:/Conditions: INSTALL 25% REDUCTION SYSTEM AT LOCATION SHOWN IN FIVE EQUAL LENGTH LINES

Comments:/Conditions: S.T. marker Installed
Turf-Tite Filter Installed
75 Infiltrator chambers Installed

INITIAL SITE SKETCH

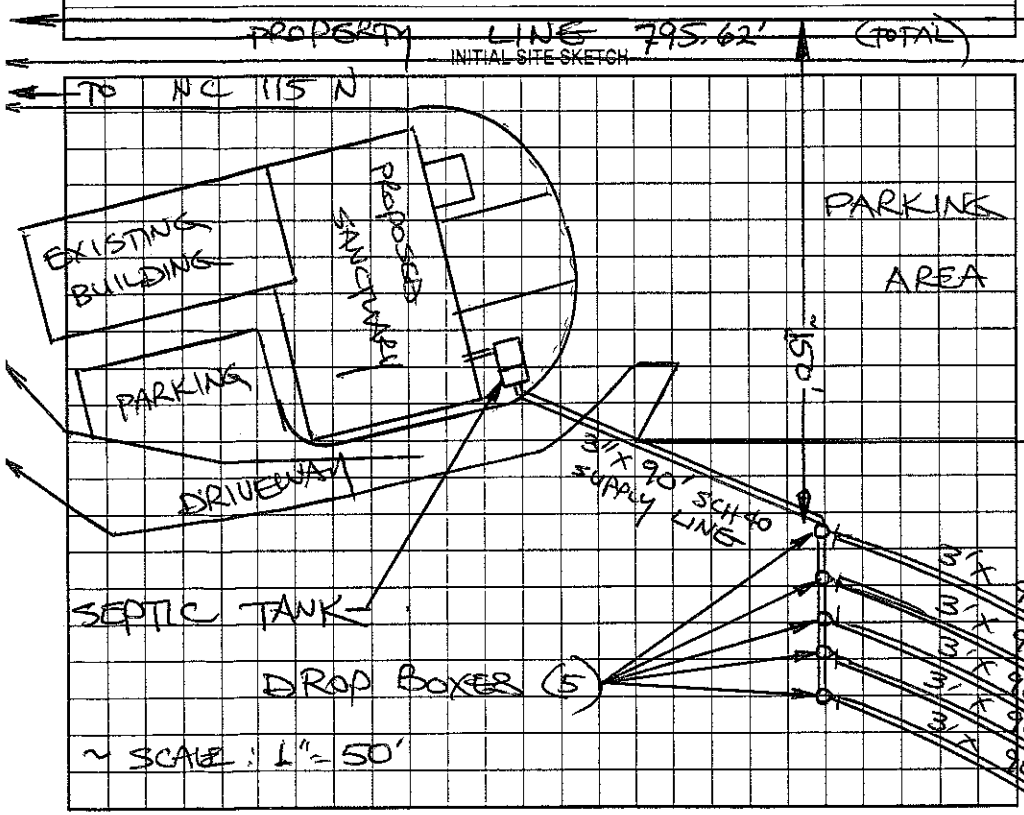

AS BUILT SKETCH

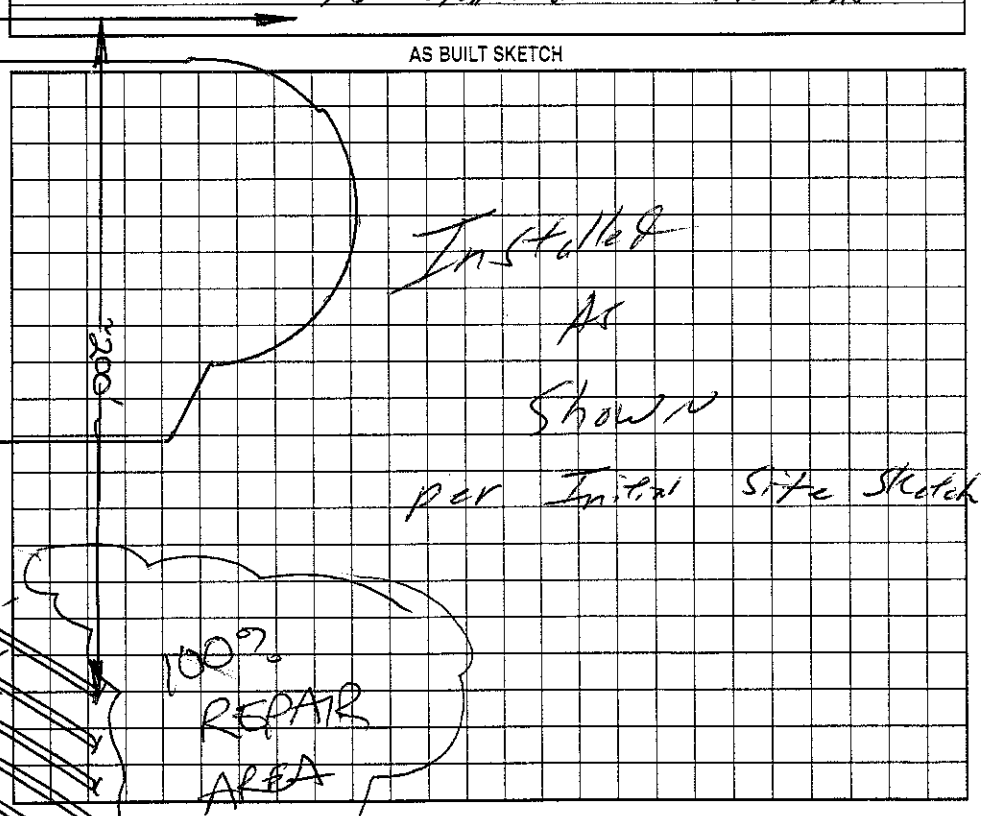

Permit can be suspended or revoked if any false information is supplied toward securing the permit/any unauthorized changes are made to the site/any unauthorized changes are made in the installation of the system. Improvement Permit with plat valid without expiration. Improvement Permit with site plan valid for sixty months. Authorization to Construct is valid for a period equal to that of Improvement Permit – not to exceed sixty months.

Signed: Donald W Hawk date 1/2/03 Installed by: Tommy Frye

Improvement Permit by: STEVE HEDRICK date 1-02-03 Operation Permit by: William O. Johnson date 1/21/03

Authorization to Construct by: STEVE HEDRICK date 1-02-03 Existing System Inspection by: date

HEALTH DEPT. COPY: WHITE OWNER COPY (FINAL): YELLOW OWNER COPY (INITIAL): PINK