IREDELL COUNTY HEALTH DEPARTMENT

Statesville Office (704) 878-5305 Mooresville Office (704) 660-3625 PERMIT # 222979

IMPROVEMENT PERMIT / AUTHORIZATION TO CONSTRUCT / OPERATION PERMIT / EXISTING SYSTEM

PIN # 4736-14-6575

APPLICANT: JERRY GODFREY APPLICANT ADDRESS: 200 DISHMAN ESTATES. STATESVILLE

SITE ADDRESS: 179 DISHMAN ESTATES LN.- Statesville PHONE: 704-578-4951 ALT. PHONE: → KATHLEEN SAUNDERS

SITE DIRECTIONS: 115 N, TR FENCE FARM, TR OLD COTTON, TL DISHMAN ESTATES

SUBDIVISION: SECTION: LOT # LOT AREA: 54.45 AC DESIGN FLOW: 480 L.T.A.R.: .3

Septic Tank 1500 (gal) STB 964 Date 9-16-16 — ☑ New System ☐ Repair ☐ Expansion System Type: I II III IV V VI — ☑ Residence No. Bedrooms 4 — Water Supply: ☑ Private ☐ Public ☐ Community

Pump Tank (gal) PT Date — System Description: 25% REDUCTION — ☐ Business No. Persons 8

Pump Make Model Serial # — Repair System Description: SAME — ☐ Other No. Employees

Nitrification Fields 1 # Lines 4@100' Linear Ft: 400' — Maintenance Agreement Required: ☐ YES ☑ NO — ☐ Slab ☐ Crawl Space

Trench Width 36" Max. Trench Bottom Depth 24" Gravel Depth — ☑ GRAVITY ☐ PRESSURE — ☑ Basement w/plumbing ☐ Basement w/o plumbing

Comments / Conditions:

25 Chambers
24 Chambers
15 "
24 "

INITIAL SITE SKETCH

SEE PLAN FROM THE OAKS GROUP

AS BUILT SKETCH

Installed Quick 4

Permit can be suspended or revoked if any false information is supplied toward securing the permit / any unauthorized changes are made to the site / any unauthorized changes are made in the installation of the system. **CONTACT A LOCATOR SERVICE PRIOR TO ANY EXCAVATION**

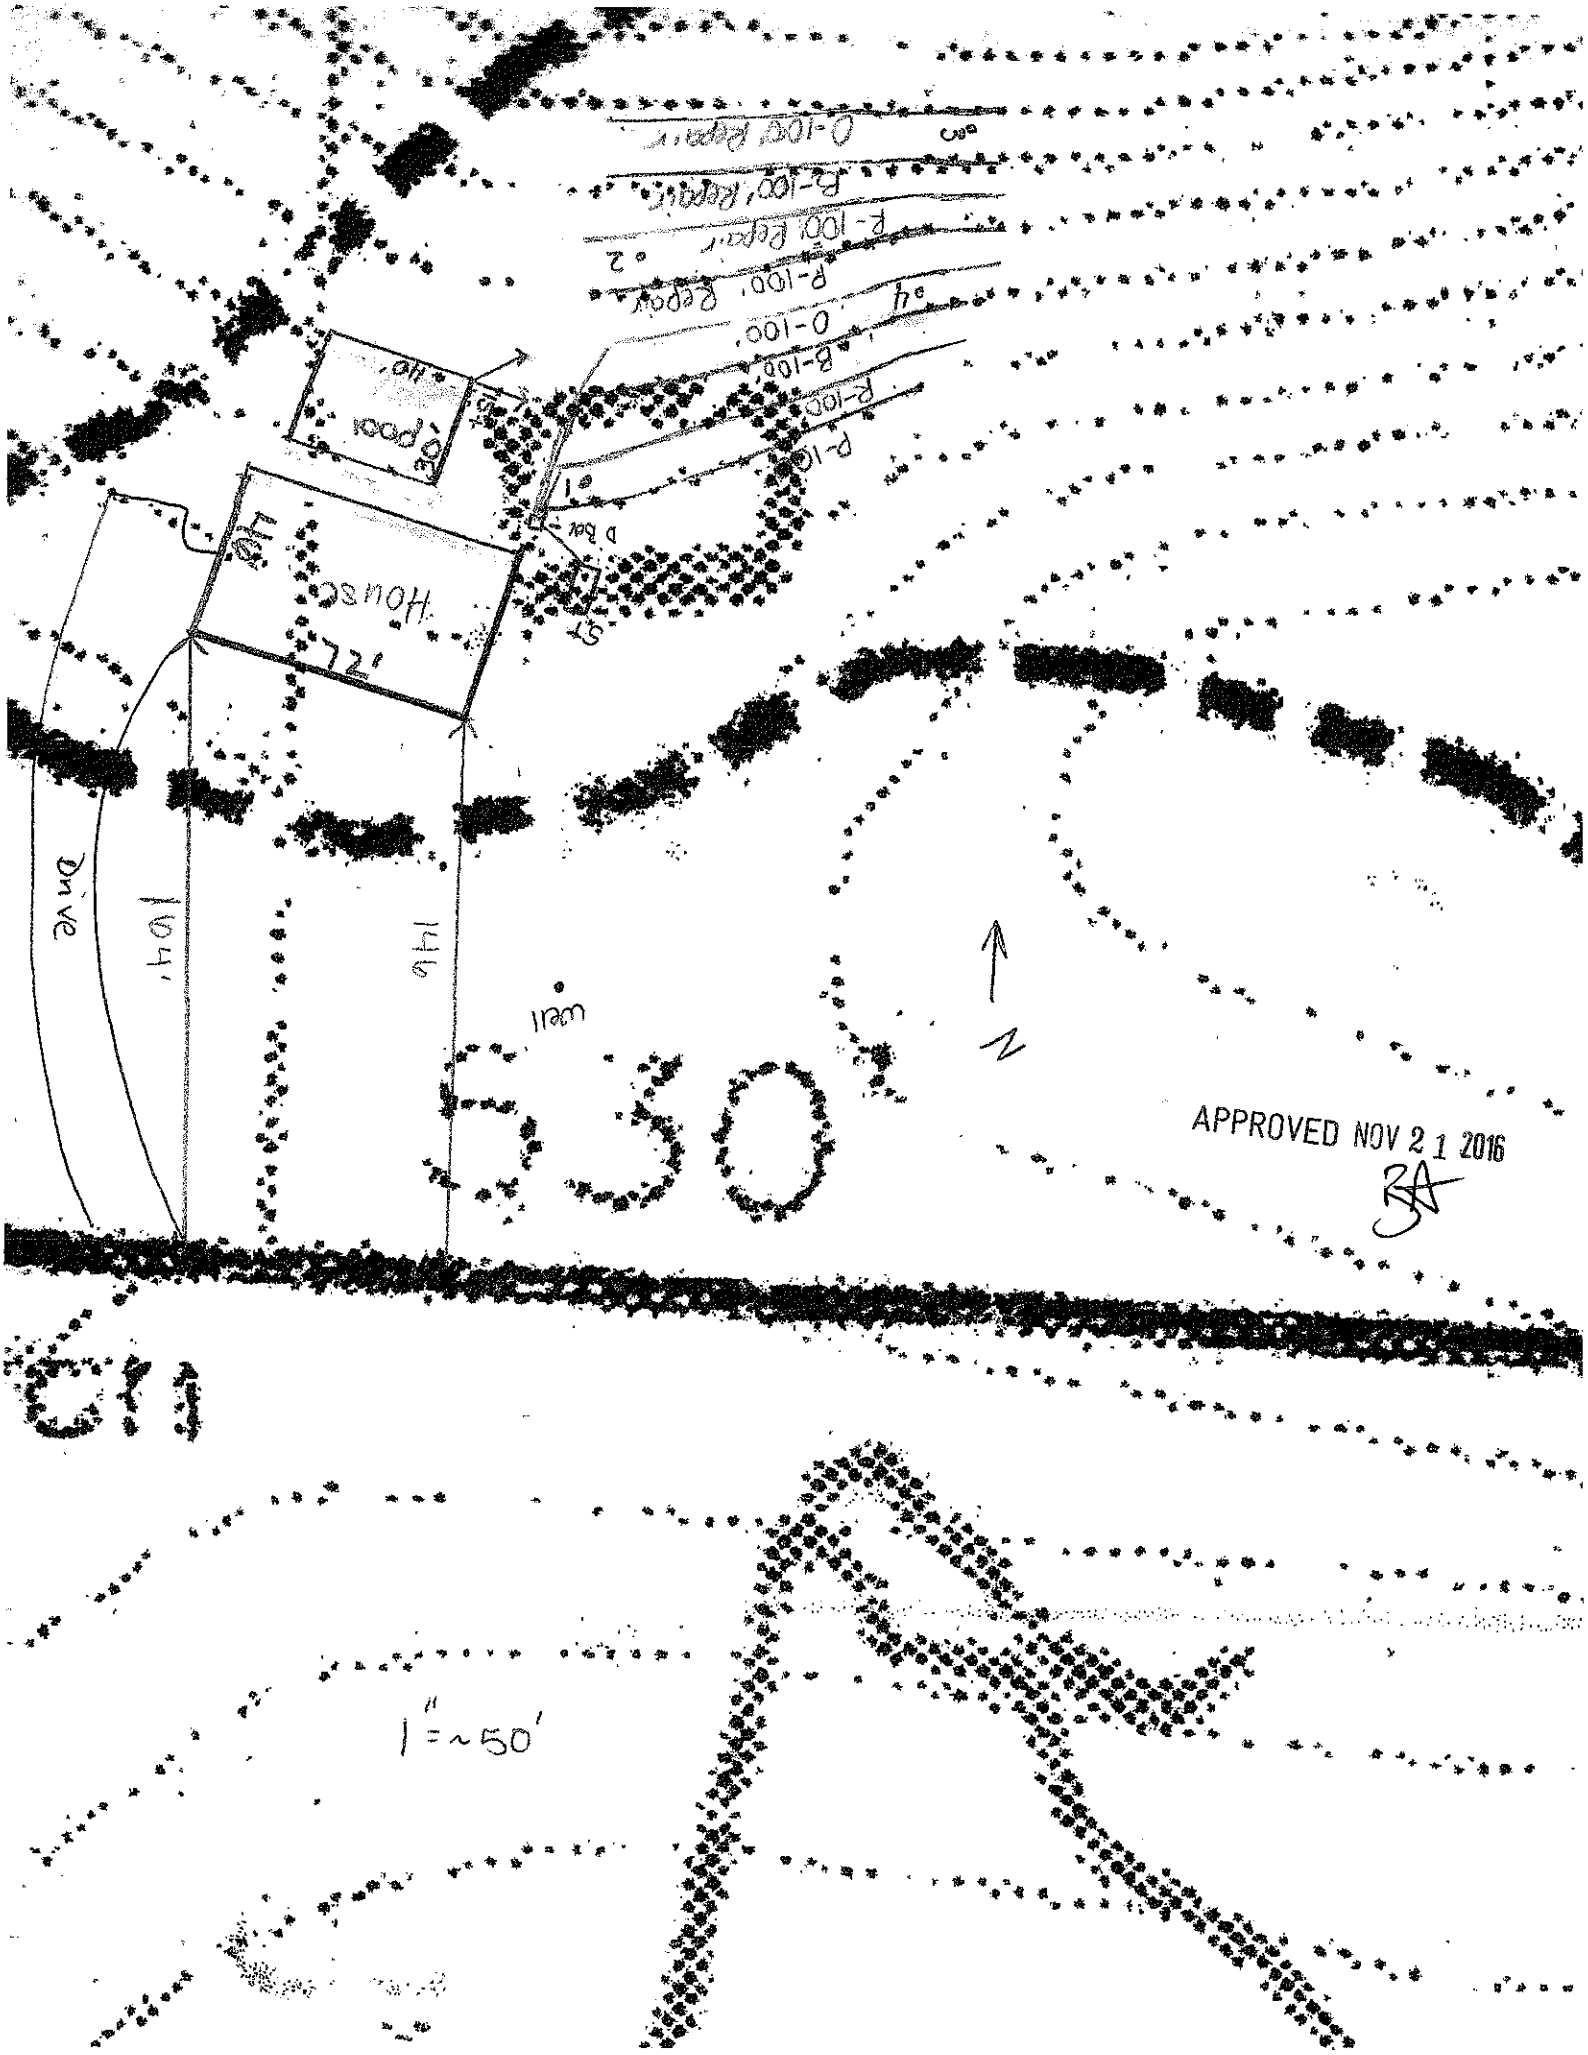
☐ **IMPROVEMENT PERMIT** *with plat valid without expiration* ☑ **IMPROVEMENT PERMIT** *with site plan valid for 60 mos.* ☑ **AUTHORIZATION TO CONSTRUCT** *valid for period equal to IMPROVEMENT PERMIT--not to exceed 60 mo.*

Owner / Applicant Signature: Kathleen Saunders Date: 11-29-16 Installed by: Ground Breakers

IMPROVEMENT PERMIT by: Date: 11-21-16 OPERATION PERMIT by: Date: 3/1/17

AUTHORIZATION TO CONSTRUCT by: Date: 11-21-16 Existing System Inspected by: Date:

Health Dept. Copy - WHITE Applicant (Final Approval) - YELLOW Applicant (Conditional Approval) - PINK


House
Pool
Drive
104
144
wall
N
APPROVED NOV 2 1 2016
1" = ~50'