IREDELL COUNTY HEALTH DEPARTMENT

STATESVILLE 704-878-5305 MOORESVILLE 704-664-5281

49690

IMPROVEMENT PERMIT / CERTIFICATE OF COMPLETION / OPERATION PERMIT / EXISTING SYSTEM INSPECTION

PROPERTY DESCRIPTION NO. 17520 DATE 12/1/93 TAX MAP NO. 10A-A-20-(19) Watershed: ☐ Yes ☑ No

OWNER OR CONTRACTOR HERITAGE BLDG. CO. PHONE: Business ____ Home 528-6644

ADDRESS RT.10, BOX 177-A STATESVILLE, NC 28677

LOCATION NC 115 N, TR SULLIVAN FARM ROAD TR MEADOW OAKS, 9TH LOT ON (R)

SUBDIVISION MEADOW OAKS BLOCK / SECTION ____ LOT 19 LOT AREA 130X230' SITE CLASS PS DESIGN FLOW 360 GPD L.T.A.R. 0.35 GPD/FT

Septic Tank: 1000 Gallons; STB 723 Date 12/23/93

Pump Tank: ____ Gallons; PT ____ Date ____

Pump Make: ____ Model ____ Serial No. ____

Nitrification Field: No Fields 1 Square Feet 1035 Linear Feet 345

No Lines 3 Trench Width 36" Max Trench Bottom Depth 18-36" Gravel Depth 12"

☑ New System ☐ Repair System Type: I, II, III, IV, V, VI (2)

System Description: CONV. GRAVITY

Repair System Description: CONV. GRAVITY

Maintenance Agreement Required: ☐ Yes ☑ No

☑ House/Mod. Home No. Bedrooms 3

☐ Mobile Home No. Bathrooms 2

☐ Business No. Employees ____

☐ Other ____


☐ Slab ☑ Crawl Space ☐ Basement w/plumbing ☐ Basement wo/plumbing

Water Supply: ☐ Individual ☐ Community ☑ Public

Comments: (1) REMOVE EXISTING FIELD TERRACE (2) KEEP SYSTEM MINIMUM 5' FROM HOUSE, 10' FROM PROPERTY LINE (3) INSTALL LINES ON CONTOUR, NO DEEPER THAN 36", 9' ON CENTER

Comments:

INITIAL SITE SKETCH

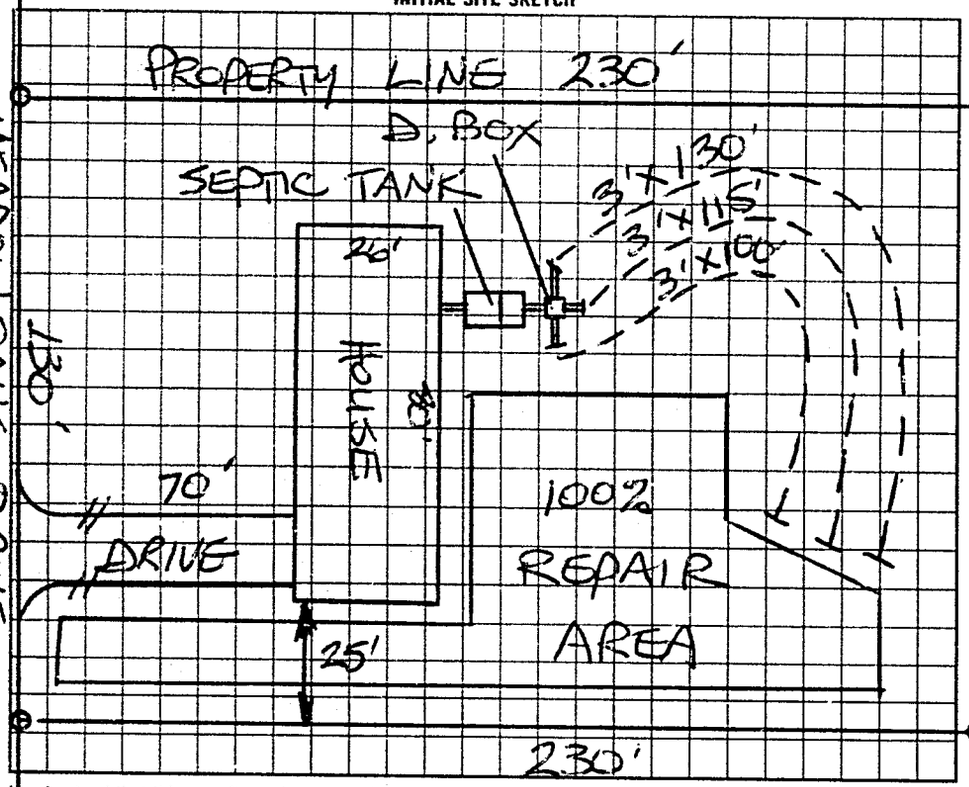

AS BUILT SKETCH

SYSTEM INSTALLED ACCORDING TO INITAL SITE SKETCH

I understand that this permit can be suspended or revoked if any false information is supplied toward securing the permit/any unauthorized changes are made to the site/any unauthorized changes are made in the installation of the system. Improvement Permit is valid for 60 months from date of issuance.

Signed [signature]

Improvement Permit by: STEVE HEDRICK date 12/1/93

Existing System Inspection by: ____ date ____

Installed by: WES LYTON

Certificate of Completion by: STEVE HEDRICK date 3/9/94

Operation Permit by: ____ date ____

HEALTH DEPT. COPY: WHITE INSPECTION COPY (FINAL): GREEN OWNER COPY (FINAL): YELLOW INSPECTION COPY (INITIAL): PINK OWNER COPY (INITIAL): GOLD