IREDELL COUNTY HEALTH DEPARTMENT

STATESVILLE 704-878-5305 MOORESVILLE 704-664-5281

52105

IMPROVEMENT PERMIT / CERTIFICATE OF COMPLETION / OPERATION PERMIT / EXISTING SYSTEM INSPECTION

PROPERTY DESCRIPTION NO. 19166 DATE 7/7/94 TAX MAP NO. 10D-1-A-21 Watershed: ☐ Yes ☑ No

OWNER OR CONTRACTOR J. TODD ELLIS PHONE: Business Home 878-6633

ADDRESS RT. 15, BOX 19 STVL NC 28677

LOCATION NC 115 N, TR SULLIVAN FARM RD, TR MEADOW OAKS DR, 6TH LOT ON (R)

SUBDIVISION MEADOW OAKS BLOCK / SECTION LOT 21 LOT AREA 130' X 230' SITE CLASS. P3 DESIGN FLOW 360 L.T.A.R. 0.35 GPD/FT²

Septic Tank: 1000 Gallons; STB 1012 Date 8-5-94

Pump Tank: Gallons; PT Date

Pump Make: Model Serial No.

Nitrification Field: No Lines 1 Square Feet 1035 Linear Feet 345

No Lines 3 Trench Width 36" Max Trench Bottom Depth 30" Gravel Depth 12"

☑ New System ☐ Repair System Type: I, II, III, IV, V, VI

System Description: CONV. GRAVITY

Repair System Description: CONV. GRAVITY

Maintenance Agreement Required: ☐ Yes ☑ No

☑ House/Mod. Home No. Bedrooms 3

☐ Mobile Home No. Bathrooms 2

☐ Business No. Employees

☐ Other


☐ Slab ☑ Crawl Space ☐ Basement w/plumbing ☐ Basement wo/plumbing

Water Supply: ☐ Individual ☐ Community ☑ Public

Comments:

Comments:

INITIAL SITE SKETCH

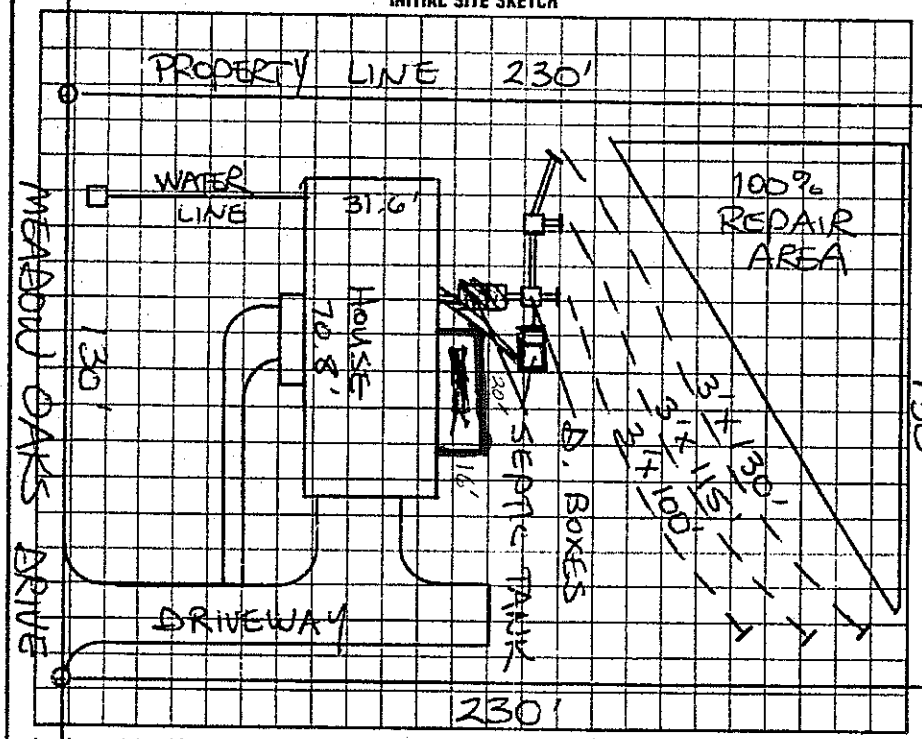

AS BUILT SKETCH

SYSTEM INSTALLED ACCORDING TO INITIAL SITE SKETCH

The location of the proposed SUNROOM addition does not appear to impact the existing septic system. **NOTE: KEEP FOUNDATION MINIMUM 5' FROM SYSTEM

R. STEVE HEDRICK REHS

Date: APRIL 19, 2011

ICHD-Environmental Health Division

I understand that this permit can be suspended or revoked if any false information is supplied toward securing the permit/any unauthorized changes are made to the site/any unauthorized changes are made in the installation of the system. Improvement Permit is valid for 60 months from date of issuance.

Signed: X

Improvement Permit by: STEVE HEDRICK date 7/7/94

Existing System Inspection by: date

Installed by: DAVID YOUNTZ

Certificate of Completion by: STEVE HEDRICK date 10/20/94

Operation Permit by: date

HEALTH DEPT. COPY: WHITE INSPECTION COPY (FINAL): GREEN OWNER COPY (FINAL): YELLOW INSPECTION COPY (INITIAL): PINK OWNER COPY (INITIAL): GOLD

6 7 9 0 0 0