IREDELL COUNTY HEALTH DEPARTMENT

Charles Dukes

STATESVILLE 704-878-5305 MOORESVILLE 704-664-5281

51273

IMPROVEMENT PERMIT / CERTIFICATE OF COMPLETION / OPERATION PERMIT / EXISTING SYSTEM INSPECTION

PROPERTY DESCRIPTION NO. 18499 DATE 5/12/94 TAX MAP NO. 10D-1-A-23 Watershed: ☐ Yes ☑ No

OWNER OR CONTRACTOR RICHARD O. CAMPBELL PHONE: Business Home 528-6860

ADDRESS RT. 1, Box 102-I TROUTMAN, 28166

LOCATION NC 115 N, TR SULLIVAN FARM RD, TR MEADOW OAKS DRIVE, 5TH LOT ON (R)

SUBDIVISION MEADOW OAKS BLOCK / SECTION I LOT 23 LOT AREA 130 x 230 SITE CLASS. #5 DESIGN FLOW 360 L.T.A.R. 0.33 gpd/ft²

Septic Tank: 1000 Gallons; STB 1012 Date 8/13/94

Pump Tank: Gallons; PT Date

Pump Make: Model Serial No.

Nitrification Field: No Fields 1 Square Feet 1080 Linear Feet 360

No Lines 4 Trench Width 36" Max Trench Bottom Depth 18"-36" Gravel Depth 12"

☑ New System ☐ Repair System Type: I, II, III, IV, V, VI

System Description: CONV. GRAVITY

Repair System Description: CONV. GRAVITY

Maintenance Agreement Required: ☐ Yes ☑ No

☑ House/Mod. Home No. Bedrooms 3

☐ Mobile Home No. Bathrooms 2

☐ Business No. Employees

☐ Other


☐ Slab ☑ Crawl Space ☐ Basement w/plumbing ☐ Basement wo/plumbing

Water Supply: ☐ Individual ☐ Community ☑ Public

Comments: ① INSTALL SYSTEM AS SHOWN, KEEPING MINIMUM 5' FROM HOUSE, 10' FROM PROPERTY LINE ② INSTALL LINES AS SHOWN FOLLOWING CONTOUR OF GROUND NO DEEPER THAN 36", 9' O.C.

Comments:

INITIAL SITE SKETCH

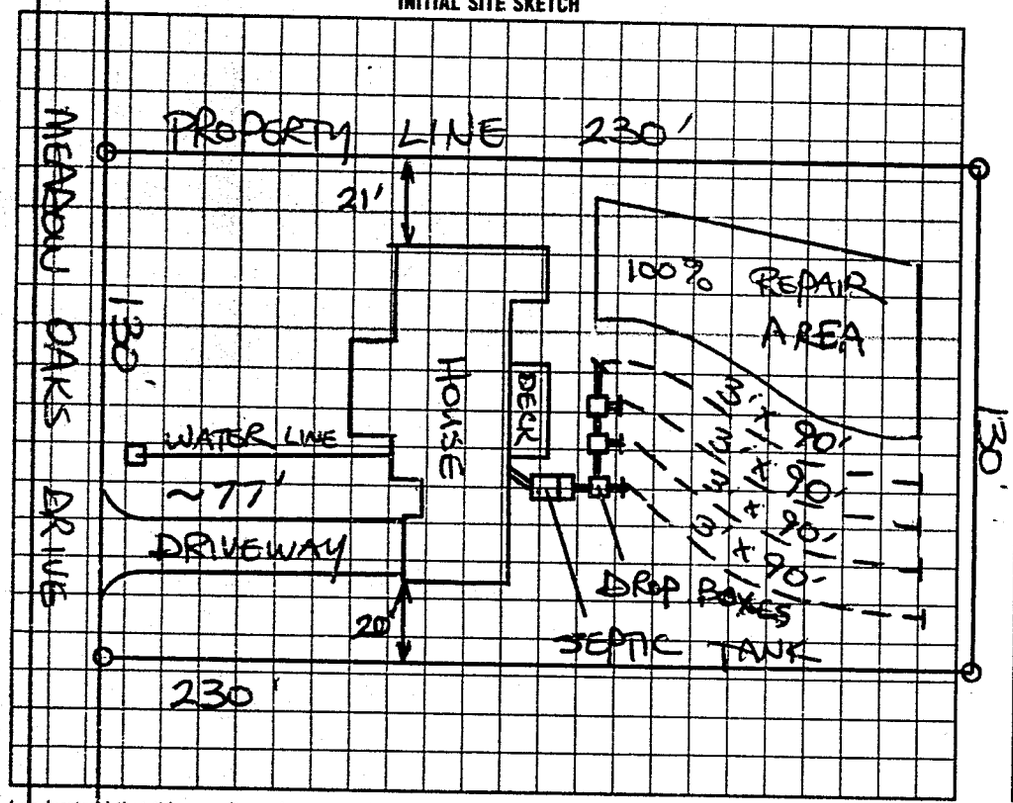

AS BUILT SKETCH

SYSTEM INSTALLED ACCORDING TO INITIAL SITE SKETCH

I understand that this permit can be suspended or revoked if any false information is supplied toward securing the permit/any unauthorized changes are made to the site/any unauthorized changes are made in the installation of the system. Improvement Permit is valid for 60 months from date of issuance.

Signed: Richard O. Campbell

Improvement Permit by: STEVE HEDRICK date 5/12/94

Existing System Inspection by: date

Installed by: DAVID YOUNTZ

Certificate of Completion by: STEVE HEDRICK date 10/28/94

Operation Permit by: date

HEALTH DEPT. COPY: WHITE INSPECTION COPY (FINAL): GREEN OWNER COPY (FINAL): YELLOW INSPECTION COPY (INITIAL): PINK OWNER COPY (INITIAL): GOLD