10D-1-A-24

50922

IREDELL COUNTY HEALTH DEPARTMENT

STATESVILLE 704-878-5305 MOORESVILLE 704-664-5281

IMPROVEMENT PERMIT / CERTIFICATE OF COMPLETION / OPERATION PERMIT / EXISTING SYSTEM INSPECTION

PROPERTY DESCRIPTION NO. 18096 DATE 3/24/94 TAX MAP NO. 10D-A- (24) Watershed: ☐ Yes ☑ No

OWNER OR CONTRACTOR JIM & MARY MIXSON PHONE: Business 876-4359 Home 873-7763

ADDRESS KENT NICHOLSON 560 KINGSWOOD DR, STVL, NC 28677

LOCATION NC 115N TR SULLIVAN FARM ROAD, TR MEADOW OAKS, 4TH LOT ON (R)

SUBDIVISION MEADOW OAKS BLOCK / SECTION LOT 24 LOT AREA SITE CLASS PS DESIGN FLOW 360 L.T.A.R. 0.35 GRAVITY

Septic Tank: 1000 Gallons; STB 1011 Date 9/13/94

Pump Tank: Gallons; PT Date

Pump Make: Model Serial No.

Nitrification Field: No Fields 1 Square Feet 1035 Linear Feet 345

No Lines 4 Trench Width 36" Max Trench Bottom Depth 18-36" Gravel Depth 12"

☑ New System ☐ Repair System Type: I, (II), III, IV, V, VI

System Description: CONVENTIONAL GRAVITY

Repair System Description: CONV. GRAVITY

Maintenance Agreement Required: ☐ Yes ☑ No

☑ House/Mod. Home No. Bedrooms

☐ Mobile Home No. Bathrooms

☐ Business No. Employees

☐ Other


☐ Slab ☑ Crawl Space ☐ Basement w/plumbing ☐ Basement wo/plumbing

Water Supply: ☐ Individual ☐ Community ☑ Public


Comments ① REMOVE EXISTING FIELD TERRACES ② KEEP SYSTEM MINIMUM 5' FROM HOUSE, 10' FROM PROPERTY LINE ③ INSTALL LINES ON CONTOUR, NO DEEPER THAN 36", 9' APART ON CENTERS.

Comments: SYSTEM INSTALLED IN FOUR LINES DUE TO TANK PLACEMENT.

INITIAL SITE SKETCH

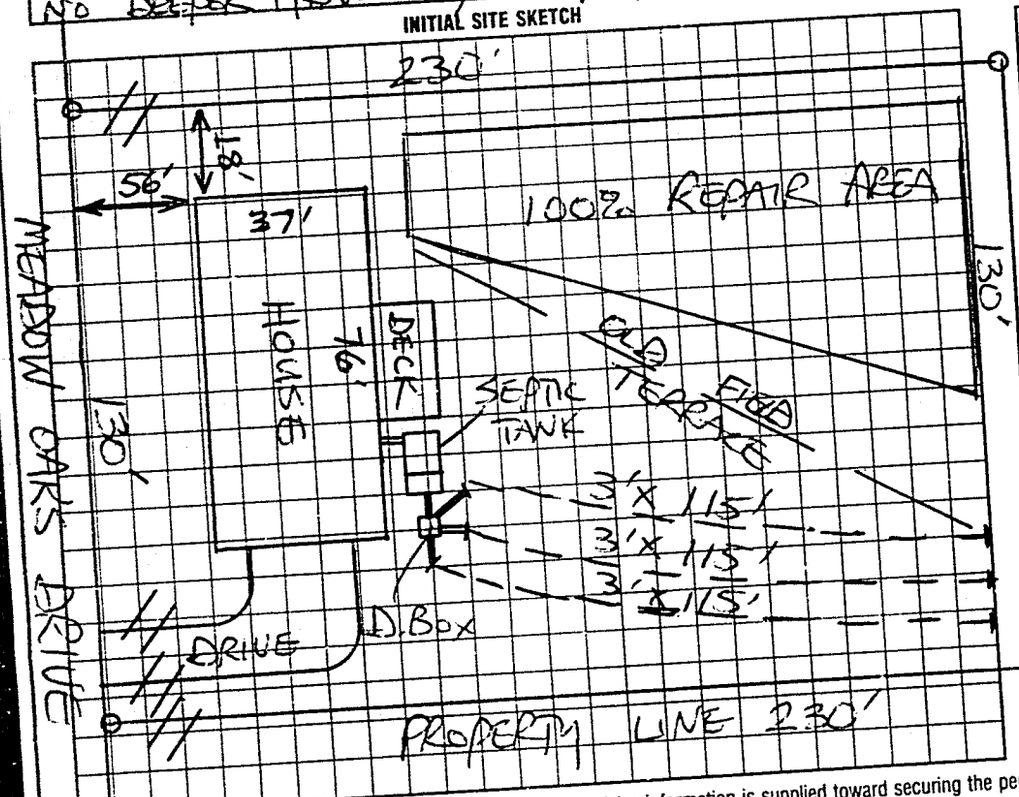

AS BUILT SKETCH

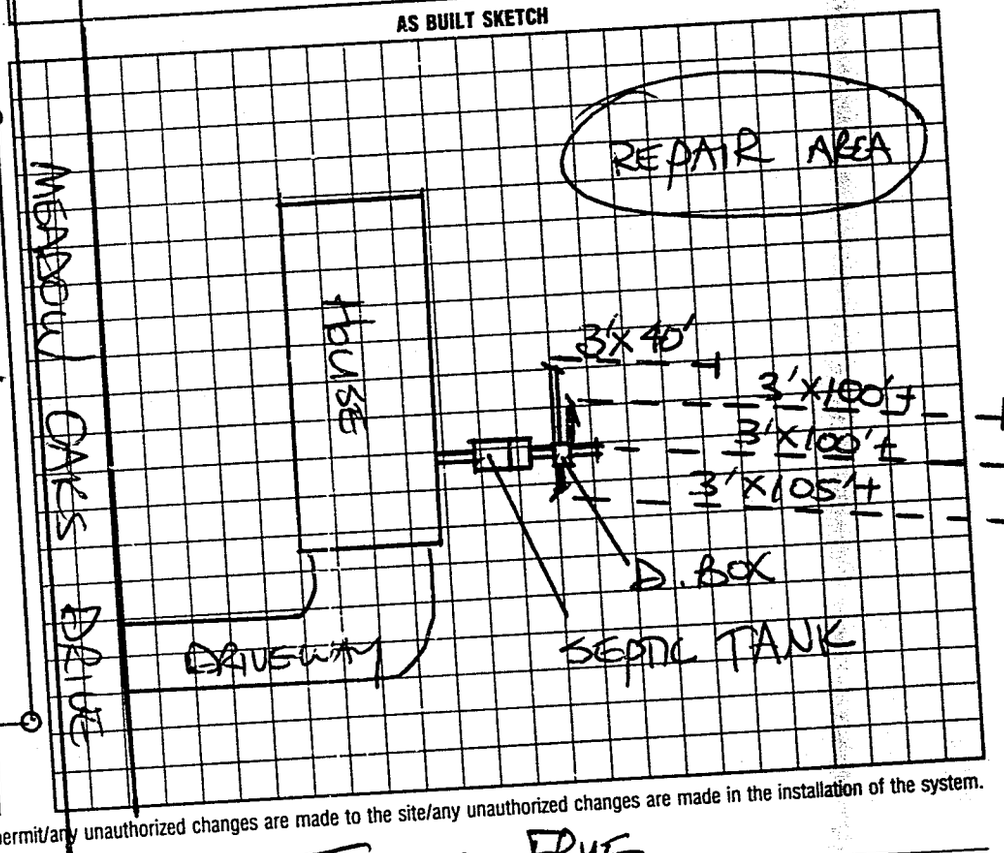

I understand that this permit can be suspended or revoked if any false information is supplied toward securing the permit/any unauthorized changes are made to the site/any unauthorized changes are made in the installation of the system. Improvement Permit is valid for 60 months from date of issuance.

Signed: [signature] date 3/24/94

Improvement Permit by STEVE HEARICK date

Existing System Inspection by

Installed by: TOMMY FRYE

Certificate of Completion by: STEVE HEARICK date

Operation Permit by: date

HEALTH DEPT. COPY: WHITE INSPECTION COPY (FINAL): GREEN OWNER COPY (FINAL): YELLOW INSPECTION COPY (INITIAL): PINK OWNER COPY (INITIAL): GOLD

669100