~~50185~~ 50185

IREDELL COUNTY HEALTH DEPARTMENT

STATESVILLE 704-878-5305 MOORESVILLE 704-664-5281

IMPROVEMENT PERMIT / CERTIFICATE OF COMPLETION / OPERATION PERMIT / EXISTING SYSTEM INSPECTION

PROPERTY DESCRIPTION NO. 17752 DATE 2/1/94 TAX MAP NO. 10D-A-20 (36) Watershed: ☐ Yes ☑ No

OWNER OR CONTRACTOR J. TODD ELLIS PHONE: Business Home 878-6033

ADDRESS Rt. 15 Box 19 STATESVILLE NC 28677

LOCATION NC 115 N TR ~~SUBDIVISION~~ SULLIVAN FARM RD TR MEADOW OAKS DR, 7TH LOT ON (C)

SUBDIVISION MEADOW OAKS BLOCK / SECTION LOT 36 LOT AREA 130x230 SITE CLASS. PS DESIGN FLOW 360 L.T.A.R. 0.35 GPD/FT2

Septic Tank: 1000 Gallons; STB 358 Date 1/4/94

Pump Tank: Gallons; PT Date

Pump Make: Model Serial No.

Nitrification Field: No Fields 1 Square Feet 1035 Linear Feet 345

No Lines 3 Trench Width 36" Max Trench Bottom Depth 30" Gravel Depth 12"

☑ New System ☐ Repair System Type: I, II, III, IV, V, VI

System Description: CONV. GRAVITY

Repair System Description: CONV. GRAVITY

Maintenance Agreement Required: ☐ Yes ☑ No

☑ House/Mod. Home ☐ Mobile Home ☐ Business ☐ Other

No. Bedrooms 3 No. Bathrooms 2 No. Employees


☐ Slab ☑ Crawl Space ☐ Basement w/plumbing ☐ Basement wo/plumbing

Water Supply: ☐ Individual ☐ Community ☑ Public

Comments: (1) KEEP SYSTEM MINIMUM 5' FROM HOUSE, 10' FROM PROPERTY LINE (2) INSTALL LINES ON CONTOUR NO DEEPER THAN 30", 9' APART ON CENTER

Comments:

INITIAL SITE SKETCH

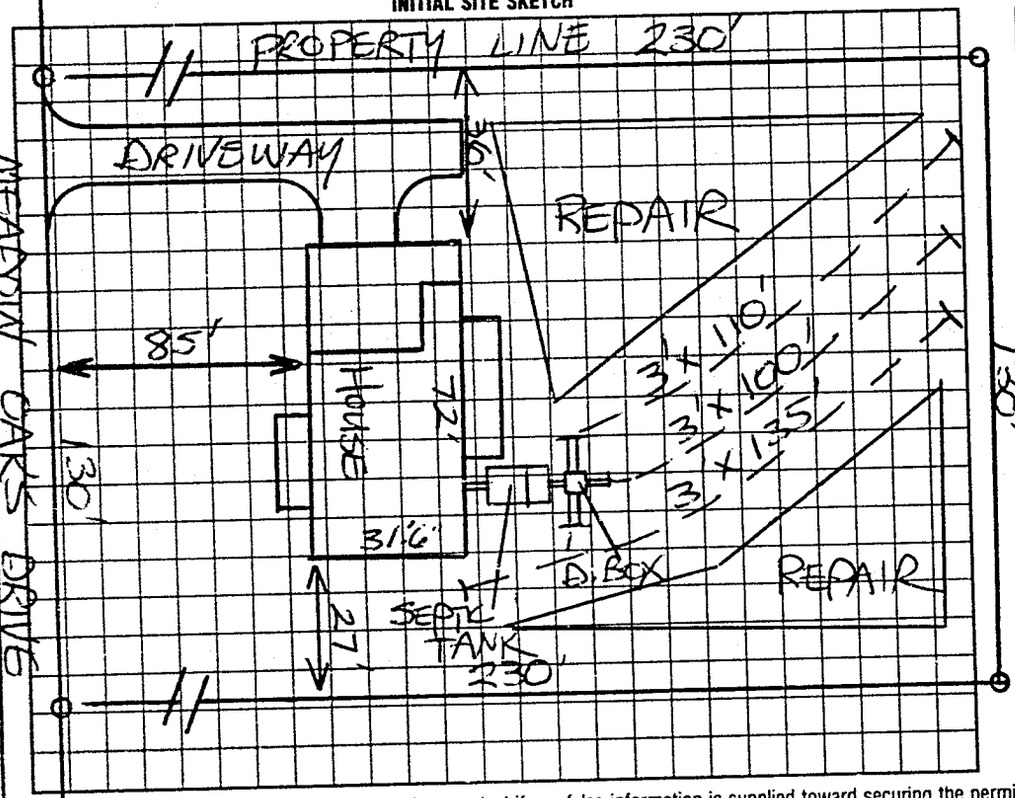

AS BUILT SKETCH

SYSTEM INSTALLED ACCORDING TO INITAL SITE SKETCH

I understand that this permit can be suspended or revoked if any false information is supplied toward securing the permit/any unauthorized changes are made to the site/any unauthorized changes are made in the installation of the system. Improvement Permit is valid for 60 months from date of issuance.

Signed: E. Wayne Rogers

Improvement Permit by: STEVE HEDRICK date 2/1/94

Existing System Inspection by: date

Installed by: DAVID YOUNTZ

Certificate of Completion by: STEVE HEDRICK date 4/27/94

Operation Permit by: date

HEALTH DEPT. COPY: WHITE INSPECTION COPY (FINAL): GREEN OWNER COPY (FINAL): YELLOW INSPECTION COPY (INITIAL): PINK OWNER COPY (INITIAL): GOLD

is 9000