57561

IREDELL COUNTY HEALTH DEPARTMENT

STATESVILLE 704-878-5305 MOORESVILLE 704-664-5281

IMPROVEMENT PERMIT / CERTIFICATE OF COMPLETION / OPERATION PERMIT / EXISTING SYSTEM INSPECTION

PROPERTY DESCRIPTION NO. 22099 DATE 9-14-95 TAX MAP NO. 10D-1-A-35 Watershed: ☐ Yes ☑ No

OWNER OR CONTRACTOR W & W SALES PHONE: Business Home 873-3388

ADDRESS P.O. BOX 5792 STATESVILLE, NC 28687

LOCATION NC 115 N, TR SULLIVAN FARM RD, TR MEADOW OAKS, LOT #35 ON LEFT

SUBDIVISION MEADOW OAKS BLOCK / SECTION LOT 35 LOT AREA 130'x230' SITE CLASS. PS DESIGN FLOW 360 L.T.A.R. 0.3 GPD/FT²

Septic Tank: 1000 Gallons; STB 1012 Date 12-15-95

Pump Tank: Gallons; PT Date

Pump Make: Model Serial No.

Nitrification Field: No Fields 1 Square Feet 1200 Linear Feet 400

No Lines 4 Trench Width 36" Max Trench Bottom Depth 18-36" Gravel Depth 12"

☑ New System ☐ Repair System Type: I, II, III, IV, V, VI

System Description: CONVENTIONAL GRAVITY

Repair System Description: CONV. GRAVITY

Maintenance Agreement Required: ☐ Yes ☑ No

☑ House/Mod. Home No. Bedrooms 3

☐ Mobile Home No. Bathrooms 2

☐ Business No. Employees

☐ Other


☐ Slab ☑ Crawl Space ☐ Basement w/plumbing ☐ Basement wo/plumbing

Water Supply: ☐ Individual ☐ Community ☑ Public

Comments: ① KEEP SYSTEM MINIMUM 10' FROM PROPERTY LINE, 5' FROM HOUSE ② INSTALL LINES ON CONTOUR, 9' MINIMUM APART ON CENTERS (BEGINNING 17' MIN. APART ON CENTERS)

Comments:

INITIAL SITE SKETCH

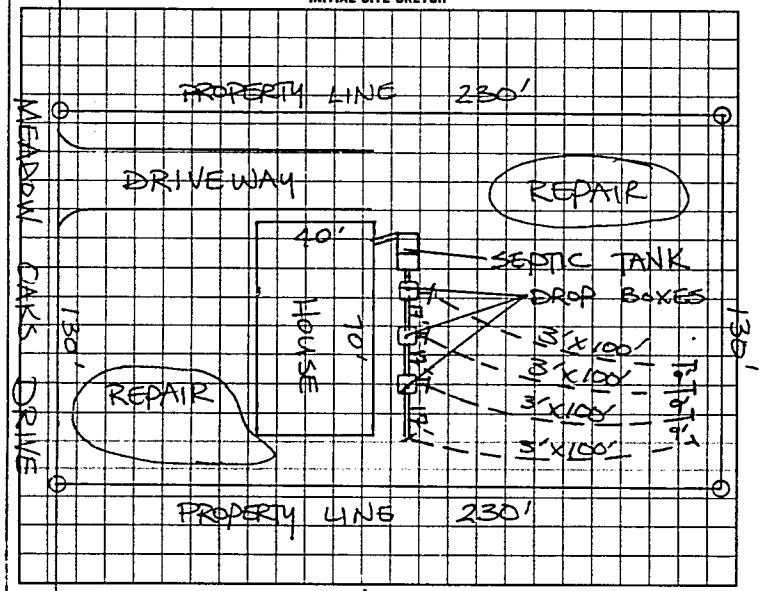

AS BUILT SKETCH

SYSTEM INSTALLED ACCORDING TO INITAL SITE SKETCH

I understand that this permit can be suspended or revoked if any false information is supplied toward securing the permit/any unauthorized changes are made to the site/any unauthorized changes are made in the installation of the system.

Signed: Nancy Wilson

Improvement Permit by: STEVE HEDRICK date 9-14-95

Existing System Inspection by: date

Installed by: Tommy Frye

Certificate of Completion by: date

Operation Permit by: STEVE HEDRICK date 2-26-96

HEALTH DEPT COPY WHITE INSPECTION COPY (FINAL) GREEN OWNER COPY (FINAL) YELLOW INSPECTION COPY (INITIAL) PINK OWNER COPY (INITIAL) GOLD

1 7 9 2 0 0