57561

IREDELL COUNTY HEALTH DEPARTMENT

STATESVILLE 704-878-5305 MOORESVILLE 704-664-5231

IMPROVEMENT PERMIT / CERTIFICATE OF COMPLETION / OPERATION PERMIT / EXISTING SYSTEM INSPECTIO

PROPERTY DESCRIPTION # 22099 DATE 9-14-95 TAX MAP NO. 10D-1-A-35 Watershed Yes

OWNER OR CONTRACTOR W & W SALES PHONE Business Home 873-3389

ADDRESS P.O. BOX 5792 STATESVILLE, NC 28687

LOCATION NC 115 N. TR SULLIVAN FARM RD TR MEADOW OAKS, LOT #35 ON LFT

SUBDIVISION MEADOW OAKS BLOCK / SECTION LOT 35 LOT AREA 130' X 230' SITE CLASS. PS DESIGN FLOW 360 L.T.A.R 0.3 GPD

Septic Tank: 1000 Gallons: STB 1912 Date 12-15-95

Pump Tank: Gallons: PT Date

Pump Make: Model Serial No

Nitrification Field: No Fields 1 Square Feet 1200 Linear Feet 400

No Lines 4 Trench Width 36" Max Trench Bottom Depth 18-36" Gravel Depth 12"

☑ New System ☐ Repair System Type: I ☑ II III IV V VI

System Description: CONVENTIONAL GRAVITY

Repair System Description CONV. GRAVITY (PUMP)

Maintenance Agreement Required: ☐ Yes ☑ No

☑ House/Mod. Home No. Bedrooms 3

☐ Mobile Home No. Bathrooms 2

☐ Business No. Employees

☐ Other


☐ Slab ☑ Crawl Space ☐ Basement w/plumbing ☐ Basement w/o plumbing

☑ Water Supp ☐ Individu ☐ Commu ☐ Public

Comments: ① KEEP SYSTEM MINIMUM 10' FROM PROPERTY LINE, 5' FROM HOUSE ② INSTALL LINES ON CONTOUR 9' MINIMUM APART ON CENTERS (BEGINNING, 17' MIN. APART ON CENTERS)

Comments:

INITIAL SITE SKETCH

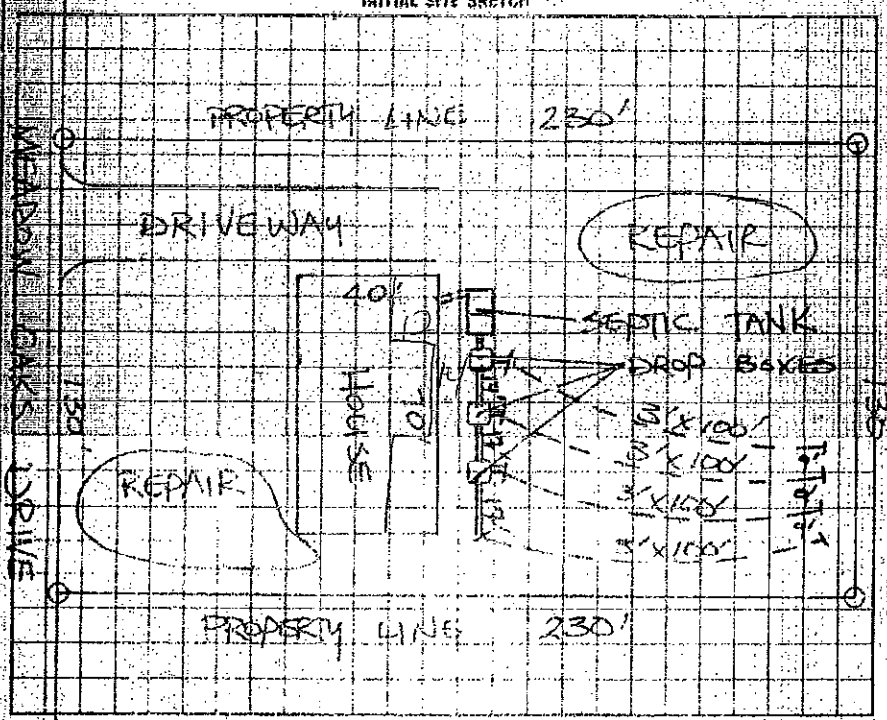

AS BUILT SKETCH

SYSTEM INSTALLED ACCORDING TO INITIAL SITE SKETCH

The proposed NW Wing addition does not appear to impact the existing septic system.

**NOTE: Maintain 5' off Septic

R.S.

Date: 12-6-95

ICHD-Environmental Health Division

I understand that this permit can be suspended or revoked if any false information is supplied toward securing the permit/any unauthorized changes are made to the site/any unauthorized changes are made in the installation of the syst

Signed Jerry Wilson

Improvement Permit by STEVE HERRICK date 9-14-95

Existing System Inspection by date

Installed by Tommy Fryer

Certificate of Completion by date

Operation Permit by STEVE HERRICK date 2-26

HEALTH DEPT. COPY - WHITE INSPECTION COPY (FINAL) - GREEN OWNER COPY (FINAL) - YELLOW INSPECTION COPY (INITIAL) - PINK OWNER COPY (INITIAL) - GOLD

JAN. 2, 1989 3:30

T L 9 2 0