IREDELL COUNTY HEALTH DEPARTMENT

STATESVILLE 704-878-5305 MOORESVILLE 704-663-5281

IMPROVEMENT PERMIT / CERTIFICATE OF COMPLETION / OPERATION PERMIT / EXISTING SYSTEM INSPECTION

PROPERTY DESCRIPTION NO. 17535 DATE 5/26/94 TAX MAP NO. 102-A-20 (50) Water Yes No

OWNER OR CONTACT HERITAGE BLDG. CO. PHONE: Business 871-7135 Home 528-6044

ADDRESS RT. 10, BOX 177 A, STATESVILLE, NC 28677

LOCATION NC 115 N. TO S. CURREY RD, TL J.P'S LANE, AT END ON (R)

SUBDIVISION MEADOW OAKS LOT NO. 50 LOT AREA ~150'x370' SITE CLASS PS DESIGN FLOW 360 L.T.A.R. 0.35 GPD/FT²

Permit No. 10CC Issued 10-15-96 Date 10/2 Type

New System ☐ Repair System Type: I (II) III IV V VI

System Description: CONVENTIONAL GRAVITY

Repair System Description: CONV. GRAVITY

Maintenance Agreement Required ☐ Yes ☑ No

Part 1 Part 2 Part 3

Tank Size 3 36" 1035 345 Trench Depth 18-30" Gravel Depth 12"

☐ House/Mod. Home No. Bedrooms 3

☐ Mobile Home No. Bathrooms 2

☐ Business No. Employees

☐ Other


☐ Slab ☐ Crawl Space ☐ Basement w/plumbing ☐ Basement w/o plumbing

Water Supply: ☐ Individual ☐ Community ☐ Public


Comments:

Comments: SYSTEM CHANGED DUE TO SITE/SOIL LOCATION W/O PRIOR H.D APPROVAL. INSTALLED AS SHOWN BELOW

INITIAL SITE SKETCH

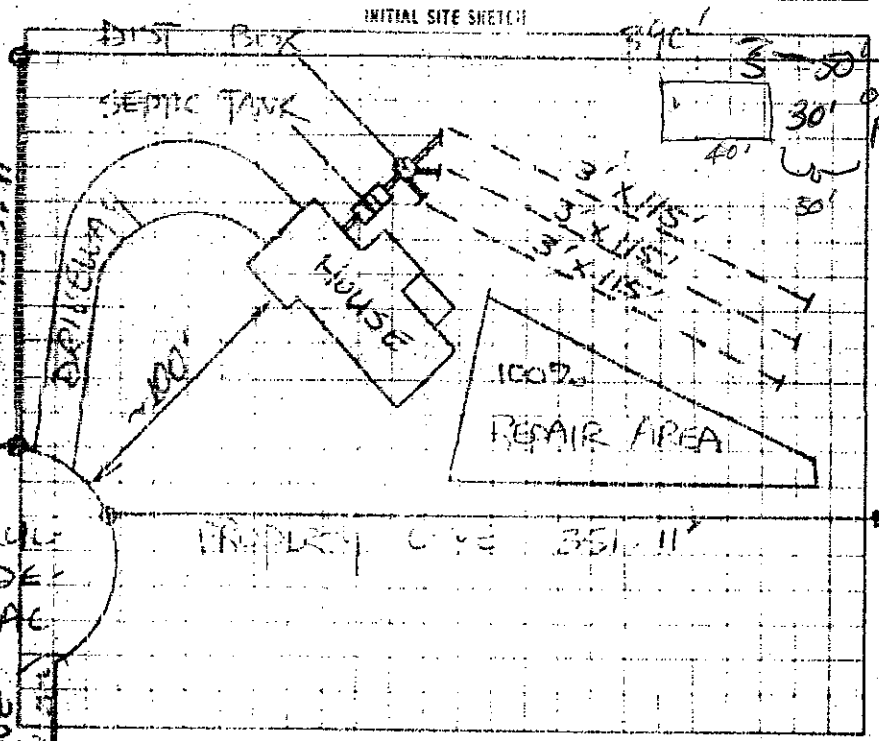

AS BUILT SKETCH

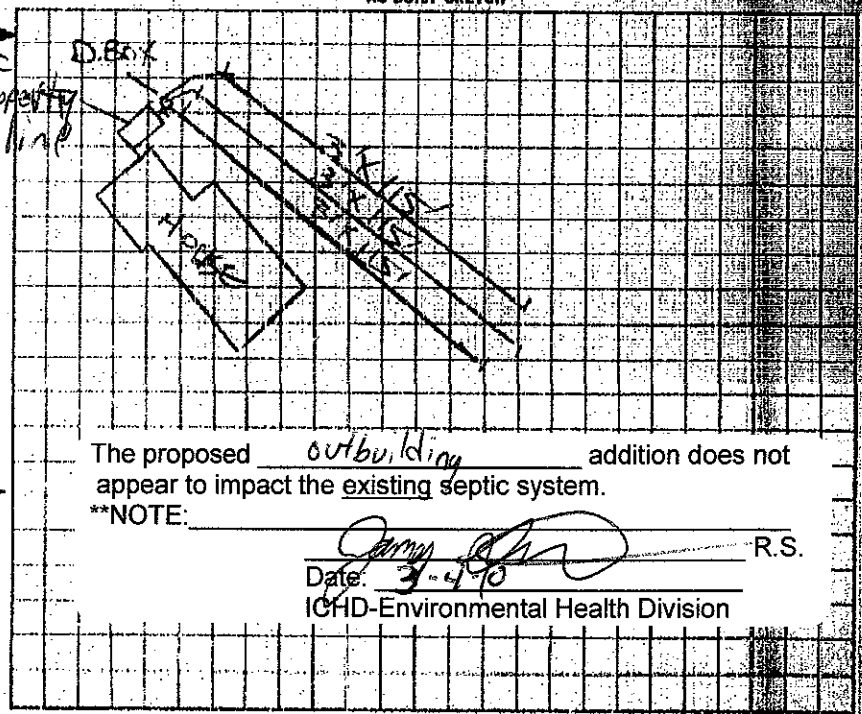

The proposed outbuilding addition does not appear to impact the existing septic system.

**NOTE:

R.S.

Date: 3-4-96

ICHD-Environmental Health Division

I understand that this permit can be suspended or revoked if any false information is supplied toward securing the permit/any unauthorized changes are made to the site/any unauthorized changes are made in the installation of the system.

Improvement Permit valid for 60 months from date of issuance

Signed

Improvement Permit by: STEVE HEDRICK date 5/26/94

Existing System Inspection by: date

Installed by: TOMMY FRYE

Certificate of Completion by: date

Operation Permit by: STEVE HEDRICK date 1-21-97

OWNER COPY (FINAL): YELLOW INSPECTION COPY (INITIAL): PINK OWNER COPY (INITIAL): GOLD

APR. 2, 1989 19:45