IREDELL COUNTY HEALTH DEPARTMENT

STATESVILLE 704-878-5305 MOORESVILLE 704-664-5281

IMPROVEMENT PERMIT / CERTIFICATE OF COMPLETION / OPERATION PERMIT / EXISTING SYSTEM INSPECTION

PROPERTY DESCRIPTION NO. 25821 DATE 1-6-97 PIN NO. 4736315049 Watershed: ☐ Yes ☑ No

OWNER OR CONTRACTOR SELF HOMES PHONE: Business Home 873-9612

ADDRESS P.O BOX 1283 STATESVILLE NC 28687

LOCATION NC 115 N TR SULLIVAN FARM ROAD TR MEADOW OAKS DRIVE, 3RD LOT ON RIGHT

SUBDIVISION MEADOW OAKS BLOCK / SECTION ____ LOT 25 LOT AREA 130' X 230' SITE CLASS. BS DESIGN FLOW 360 L.T.A.R. 0.3 GPD/FT2

Septic Tank: 1000 Gallons; STB 1012 Date 4-5-97
Pump Tank: ____ Gallons; PT ____ Date ____
Pump Make: ____ Model ____ Serial No. ____
Nitrification Field: No Fields 1 Square Feet 1200 Linear Feet 400
No Lines FOUR Trench Width 36" Max Trench Bottom Depth 36" Gravel Depth 12"

☑ New System ☐ Repair System Type: I, II, III, IV, V, VI
System Description: CONV GRAVITY
Repair System Description: CONV. GRAVITY
Maintenance Agreement Required: ☐ Yes ☑ No

☑ House/Mod. Home No. Bedrooms 3
☐ Mobile Home No. Bathrooms 2
☐ Business No. Employees ____
☐ Other ____


☐ Slab ☑ Crawl Space ☐ Basement w/plumbing ☐ Basement wo/plumbing

Water Supply:
☐ Individual
☐ Community
☑ Public

Comments:

Comments:

INITIAL SITE SKETCH SCALE: 1"=40'

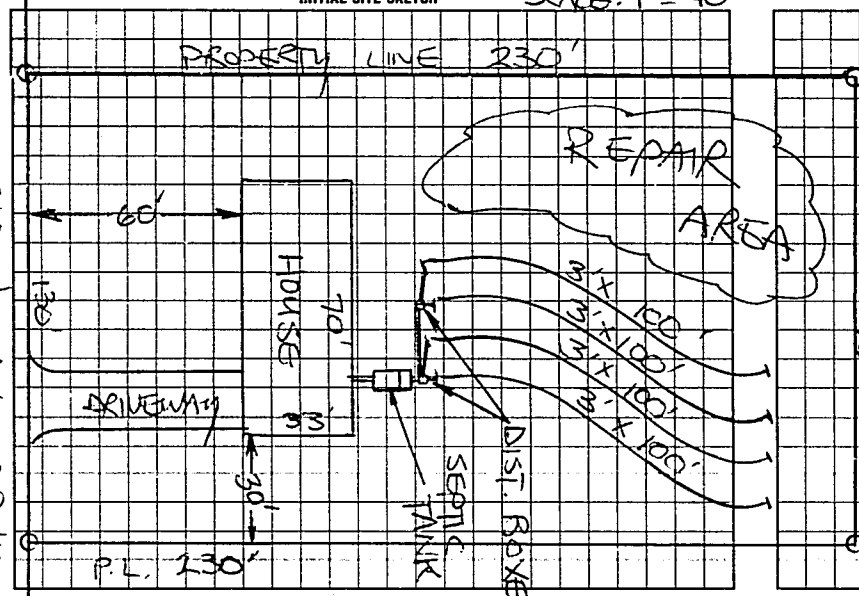

AS BUILT SKETCH

Installed as shown

I understand that this permit can be suspended or revoked if any false information is supplied toward securing the permit/any unauthorized changes are made to the site/any unauthorized changes are made in the installation of the system. Improvement Permit is valid for 60 months from date of issuance. AUTH. TO CONST. IS VALID FOR 60 MONTHS.

Signed: + SELF Homes, INC 2 PAGES. Installed by: David Young

Improvement Permit by: STEVE HENRICK date 1-6-97

~~Certificate of Completion by:~~ ____ date ____

AUTH. TO CONST ~~Existing System Inspection by~~ STEVE HENRICK date 1-6-97

Operation Permit by: Mark C Oates date 5-23-97

HEALTH DEPT. COPY: WHITE | INSPECTION COPY (FINAL): GREEN | OWNER COPY (FINAL): YELLOW | INSPECTION COPY (INITIAL): PINK | OWNER COPY (INITIAL): GOLD

iss200