IREDELL COUNTY HEALTH DEPARTMENT

STATESVILLE 704-878-5305 MOORESVILLE 704-664-5281

IMPROVEMENT PERMIT / AUTHORIZATION TO CONSTRUCT / OPERATION PERMIT / EXISTING SYSTEM INSPECTION

PERMIT# 073449 PIN# 4736 31 5261

OWNER OR CONTRACTOR Kenny Watt PHONE: Business 876-0047 Home DATE 6-2-98

ADDRESS 129 Beckham Rd Sta.

LOCATION 115 N TR Sullivan Fm Rd TR Meadow Oaks Dr. 2nd lot Rt

SUBDIVISION Meadow Oaks BLOCK / SECTION LOT 26 LOT AREA 130' X 195' SITE CLASS PS DESIGN FLOW 360 L.T.A.R. .33

Septic Tank: 1000 Gallons; STB 1012 Date 3-8-99

Pump Tank: Gallons; PT Date

Pump Make: Model Serial No.

Nitrification Field: No Fields 1 Square Feet 1080 Linear Feet 360

No Lines 3 Trench Width 36" Max Trench Bottom Depth 36" Gravel Depth 12"

☒ New System ☐ Repair System Type: I (II) III. IV. V. VI

System Description: Conv. Gravity

Repair System Description:

Maintenance Agreement Required: ☐ Yes ☒ No

☒ House/Mod. Home ☐ Mobile Home ☐ Business ☐ Other

No. Bedrooms 3 No. Bathrooms 2 No. Employees


Water Supply: ☐ Individual ☒ Public ☐ Community

☐ Slab ☒ Crawl Space ☐ Basement w/plumbing ☐ Basement wo/plumbing


Comments:/Conditions:

Comments:/Conditions:

INITIAL SITE SKETCH

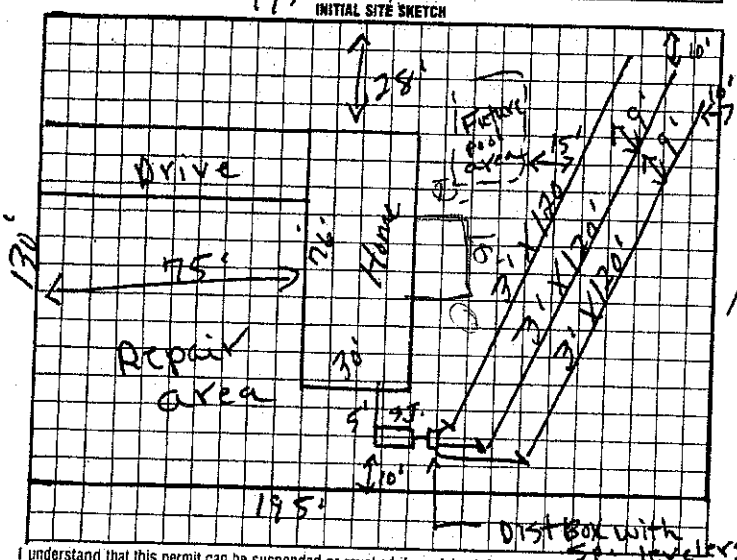

AS BUILT SKETCH

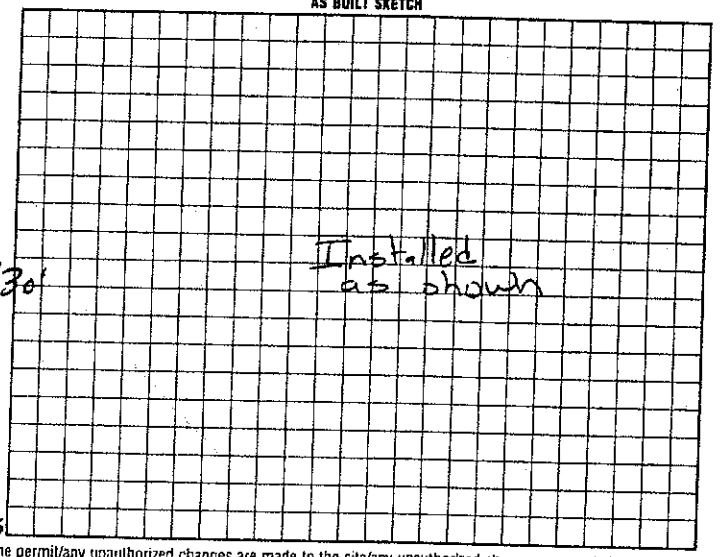

I understand that this permit can be suspended or revoked if any false information is supplied toward securing the permit/any unauthorized changes are made to the site/any unauthorized changes are made in the installation of the system. Improvement Permit with plat valid without expiration. Improvement Permit with site plan valid for sixty months. Authorization to Construct is valid for a period equal to that of Improvement Permit – not to exceed sixty months.

Signed: Kenneth A Watt

Improvement Permit by: R. C. Moore date 6-2-98

Authorization to Construct by: R. C. Moore date 6-2-98

HEALTH DEPT COPY: WHITE INSPECTION COPY (FINAL): GREEN OWNER COPY (FINAL) YELLOW

Installed by: David Yountz Mgr Cert PS date 4-26-99

Operation Permit by: date

Existing System Inspection by: date

INSPECTION COPY (INITIAL): PINK OWNER COPY (INITIAL): GOLD

The proposed ~~existing~~ deck roof addition does not appear to impact the existing septic system.

**NOTE:

R. STEVE HEDRICK REHS

Date: 8-11-10

ICHD-Environmental Health Division