IREDELL COUNTY HEALTH DEPARTMENT

STATESVILLE 704-878-5305 (1) MOORESVILLE 704-664-5281

IMPROVEMENT PERMIT / AUTHORIZATION TO CONSTRUCT / OPERATION PERMIT / EXISTING SYSTEM INSPECTION

PERMIT# 18234 PIN# 4736-31-5496 DATE 3-12-04

OWNER OR CONTRACTOR Danny Lippard Construction Co. PHONE: Business (704) 902-4918 Home —

ADDRESS P.O. Box 629 Statesville N.C. 28677

LOCATION Hwy 21 N. (1) Fort Dobbs (R) Cauley Ford (L) Sullivan Farm (2) Meadow Oaks Dr. lot on Right Corner

SUBDIVISION Meadow Oaks BLOCK / SECTION 1 LOT 28 LOT AREA .603 Ac. SITE CLASS. 5 DESIGN FLOW 360 L.T.A.R. .25 gpd/ft2

Septic Tank: 1000 Gallons; STB 1012 Date 5-16-04
Pump Tank: 1000 Gallons; PT 17 Date 5-3-02
Pump Make: GOULDS Model WED3122 MA Serial No. D0458575
Nitrification Field: No Fields 1 Square Feet 1440 Linear Feet 360
No Lines 4@90 Trench Width 36" Max Trench Bottom Depth 32" Gravel Depth NA

(X) New System ( ) Repair System Type: I, II, (III), IV, V, VI
System Description: Pump, 25% Reduction
Repair System Description: LP Panel
Maintenance Agreement Required: ( ) Yes (X) No

(X) House/Mod. Home No. Bedrooms 3
( ) Mobile Home No. Bathrooms 2½
( ) Business No. Employees
( ) Other


Water Supply: ( ) Individual (X) Public ( ) Community

( ) Slab (X) Crawl Space ( ) Basement w/plumbing ( ) Basement wo/plumbing

Comments:/Conditions: (1) Do not cut for Positive Drainage Setback on West side of House. House must be kept out of ground. No foundation drain on west side of House or Permit will be Voided. (2) Install lines on Contour.

Comments:/Conditions: SEPTIC TANK WITH MARKER INSTALLED USING "TUFTITE" FILTER

INITIAL SITE SKETCH

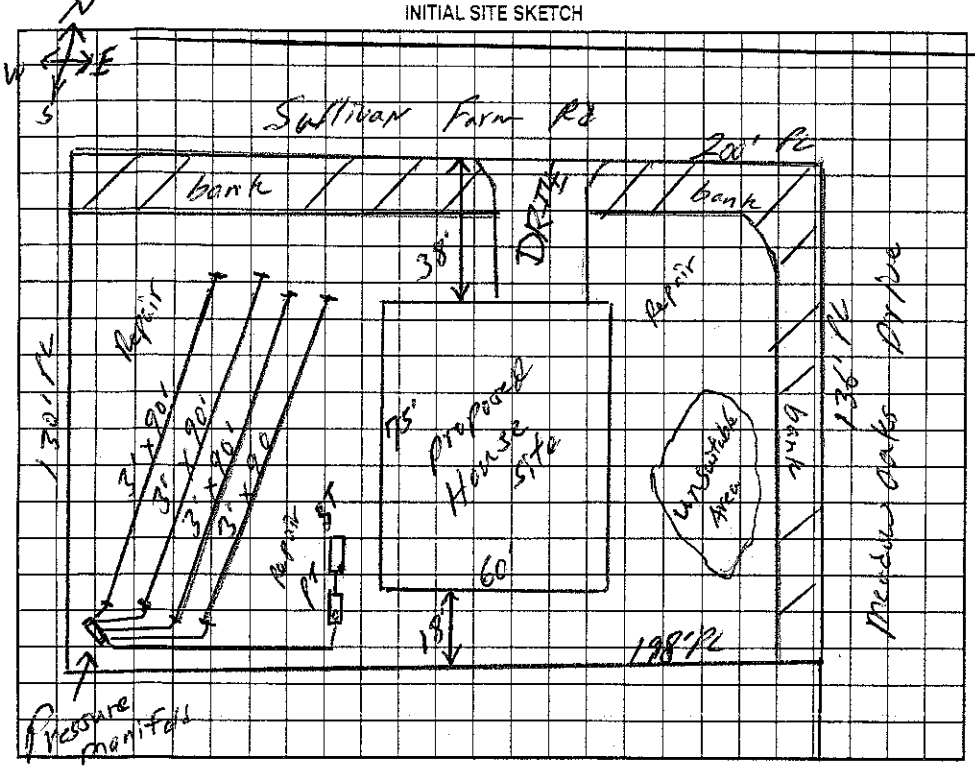

AS BUILT SKETCH

SYSTEM INSTALLED ACCORDING TO INITAL SITE SKETCH

Permit can be suspended or revoked if any false information is supplied toward securing the permit/any unauthorized changes are made to the site/any unauthorized changes are made in the installation of the system. Improvement Permit with plat valid without expiration. Improvement Permit with site plan valid for sixty months. Authorization to Construct is valid for a period equal to that of Improvement Permit – not to exceed sixty months.

Signed: [signature] date 3-19-04 Installed by: DAVID YOUNTZ

Improvement Permit by: William A. Johnson date 3-12-04 Operation Permit by: STEVE HEDRICK date 9-14-05

Authorization to Construct by: William A. Johnson date 3-17-04 Existing System Inspection by: _____ date _____

HEALTH DEPT. COPY: WHITE OWNER COPY (FINAL): YELLOW OWNER COPY (INITIAL): PINK