IREDELL COUNTY HEALTH DEPARTMENT

STATESVILLE 704-878-5305 MOORESVILLE 704-664-5281

IMPROVEMENT PERMIT / CERTIFICATE OF COMPLETION / OPERATION PERMIT / EXISTING SYSTEM INSPECTION

PROPERTY DESCRIPTION NO. 069057 DATE 8-25-97 TAX MAP NO. 4736317399 Watershed: ☐ Yes ☑ No

OWNER OR CONTRACTOR TODD ELLIS PHONE: Business Home 878-6633

ADDRESS 178 MEADOW OAKS, STATESVILLE NC 28625

LOCATION NC 115 N, TR SULLIVAN FARM ROAD, TR MEADOW OAKS DRIVE, 1ST LOT ON LEFT

SUBDIVISION MEADOW OAKS BLOCK / SECTION LOT 29 LOT AREA 0.80 Acre SITE CLASS. PS DESIGN FLOW 360 L.T.A.R. 0.33 GPD/FT²

Septic Tank: 1000 Gallons; STB 1012 Date 5-3-98

Pump Tank: Gallons; PT Date

Pump Make: Model Serial No.

Nitrification Field: No Fields 1 Square Feet 1080 Linear Feet 360

No Lines THREE Trench Width 36" Max Trench Bottom Depth 36" Gravel Depth 12"

☑ New System ☐ Repair System Type: I, II, III, IV, V, VI

System Description: CONVENTIONAL GRAVITY

Repair System Description: CHAMBERED GRAVITY

Maintenance Agreement Required: ☐ Yes ☑ No

☑ House/Mod. Home No. Bedrooms 3

☐ Mobile Home No. Bathrooms 2

☐ Business No. Employees

☐ Other


☐ Slab ☑ Crawl Space ☐ Basement w/plumbing ☐ Basement wo/plumbing

Water Supply: ☐ Individual ☐ Community ☑ Public

Comments: SCOUR TRENCH SIDEWALLS WHERE SMEARING OCCURS

Comments:

INITIAL SITE SKETCH SCALE: 1" = 50'

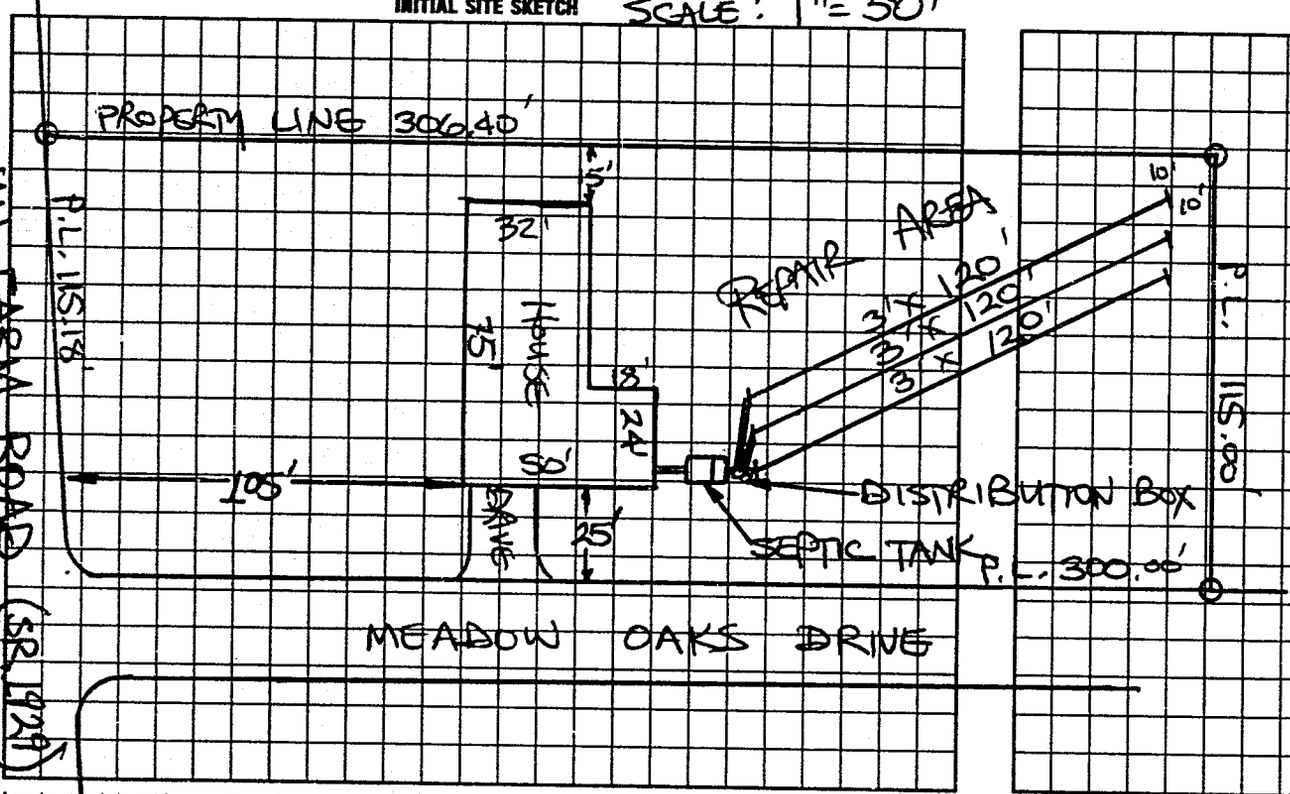

AS BUILT SKETCH

Same as initial sketch

I understand that this permit can be suspended or revoked if any false information is supplied toward securing the permit/any unauthorized changes are made to the site/any unauthorized changes are made in the installation of the system. Improvement Permit is valid for 60 months from date of issuance. AUTHORIZATION TO CONSTRUCT IS VALID FOR 60 MONTHS FROM DATE OF ISSUANCE.

Signed: [signature]

Improvement Permit by: STEVE HEDRICK date 8-25-97

AMD-TO CONST. Existing System Inspection by: STEVE HEDRICK date 8-25-97

Installed by: Eddie Younts & Son

~~Certificate of Completion by:~~ date

Operation Permit by: P.C. Moore date 7-10-98

HEALTH DEPT. COPY: WHITE INSPECTION COPY (FINAL): GREEN OWNER COPY (FINAL): YELLOW INSPECTION COPY (INITIAL) PINK OWNER COPY (INITIAL) GOLD