Todd Ellis

IREDELL COUNTY HEALTH DEPARTMENT

STATESVILLE 704-878-5305 MOORESVILLE 704-664-5281

IMPROVEMENT PERMIT / CERTIFICATE OF COMPLETION / OPERATION PERMIT / EXISTING SYSTEM INSPECTION

PROPERTY DESCRIPTION NO. 23732 6351O DATE 5-6-96 TAX MAP NO. 10D-1-32

OWNER OR CONTRACTOR J. TODD ELLIS PHONE: Business Home 878-6633 Watershed: ☐ Yes ☒ No

ADDRESS 178 MEADOW OAKS DR STATESVILLE NC 28677

LOCATION NC 115 N, TR SULLIVAN FARM TR MEADOW OAKS 3RD LT ON LEFT

SUBDIVISION MEADOW OAKS BLOCK / SECTION LOT 32 LOT AREA 130x230 SITE CLASS PS DESIGN FLOW 360 L.T.A.R. 0.33 GPD/FT2

Septic Tank: 1000 Gallons; STB 1012 Date 3-24-97

Pump Tank: Gallons; PT Date

Pump Make: Model Serial No.

Nitrification Field: No Fields 1 Square Feet 1080 Linear Feet 360

No Lines 4 Trench Width 36" Max Trench Bottom Depth 18-36" Gravel Depth 12"

☒ New System ☐ Repair System Type: I. II. III. IV. V. VI

System Description: CONV. GRAVITY

Repair System Description: CONV. GRAVITY

Maintenance Agreement Required: ☐ Yes ☒ No

☒ House/Mod. Home No. Bedrooms 3

☐ Mobile Home No. Bathrooms 2

☐ Business No. Employees

☐ Other


☐ Slab ☒ Crawl Space ☐ Basement w/plumbing ☐ Basement wo/plumbing

Water Supply: ☐ Individual ☐ Community ☒ Public


Comments:

Comments:

INITIAL SITE SKETCH

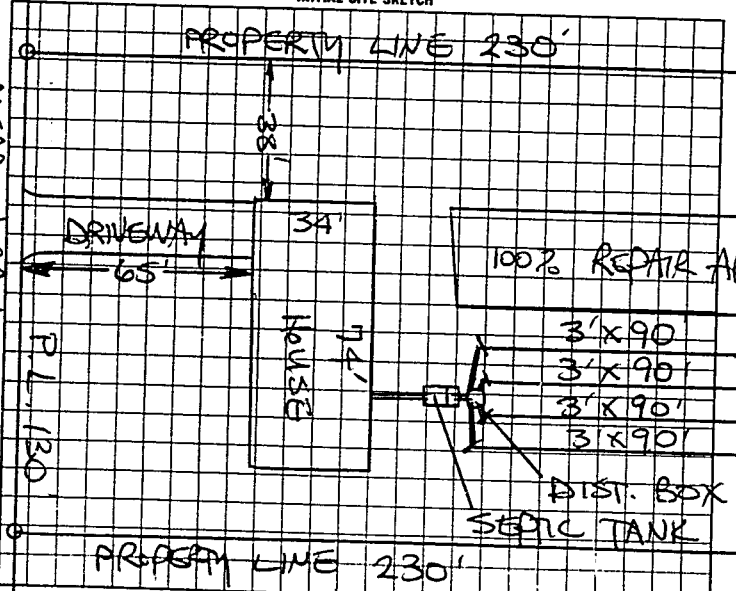

AS BUILT SKETCH

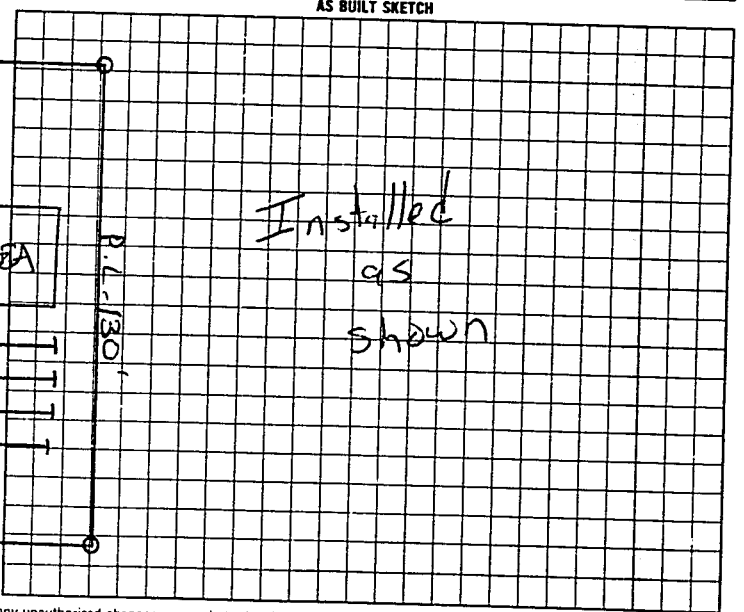

I understand that this permit can be suspended or revoked if any false information is supplied toward securing the permit/any unauthorized changes are made to the site/any unauthorized changes are made in the installation of the system.

Authorization to Construct is valid five (5) years from date of issuance. Improvement Permit has no expiration date.

Signed:

Improvement Permit by: STEVE HEDRICK date 5-6-96

Existing System Inspection by: STEVE HEDRICK date 5-6-96

AUTHORIZATION TO CONSTRUCT:

Installed by: David Yountz

Certificate of Completion by: date

Operation Permit by: Mark C. Watts RS date 5-22-97

HEALTH DEPT COPY: WHITE INSPECTION COPY (FINAL) GREEN OWNER COPY (FINAL) YELLOW INSPECTION COPY (INITIAL) PINK OWNER COPY (INITIAL) GOLD