IREDELL COUNTY HEALTH DEPARTMENT

STATESVILLE 704-878-5305 MOORESVILLE 704-664-5281

50465

IMPROVEMENT PERMIT / CERTIFICATE OF COMPLETION / OPERATION PERMIT / EXISTING SYSTEM INSPECTION

PROPERTY DESCRIPTION NO. 17937 DATE 3/4/94 TAX MAP NO. 10D-1-A-31 Watershed: ☐ Yes ☒ No

OWNER OR CONTRACTOR JEFFREY T. ELLIS PHONE: Business Home 878-6633

ADDRESS Rt. 15 Box 19 STVL, NC 28677

LOCATION NC 115 N, TR SULLIVAN FARM, TR MEADOW OAKS DRIVE, 1ST LOT ON (L)

SUBDIVISION MEADOW OAKS BLOCK / SECTION LOT 31 LOT AREA 130 x 230 SITE CLASS. PS1 DESIGN FLOW 360 L.T.A.R. 0.356PA

Septic Tank: 1000 Gallons; STB 358 Date 1/6/94

Pump Tank: Gallons; PT Date

Pump Make: Model Serial No.

Nitrification Field: No Fields 1 Square Feet 1035 Linear Feet 345

No Lines 4 Trench Width 36" Max Trench Bottom Depth 18-36 Gravel Depth 12"

☒ New System ☐ Repair System Type: I (II) III, IV, V, VI

System Description: CONV. GRAVITY

Repair System Description: CONV. GRAVITY

Maintenance Agreement Required: ☐ Yes ☒ No

☒ House/Mod. Home No. Bedrooms 3

☐ Mobile Home No. Bathrooms 2

☐ Business No. Employees

☐ Other

☐ Slab ☒ Crawl Space ☐ Basement w/plumbing ☐ Basement wo/plumbing


Water Supply: ☐ Individual ☐ Community ☒ Public

Comments:

0

Comments:

INITIAL SITE SKETCH

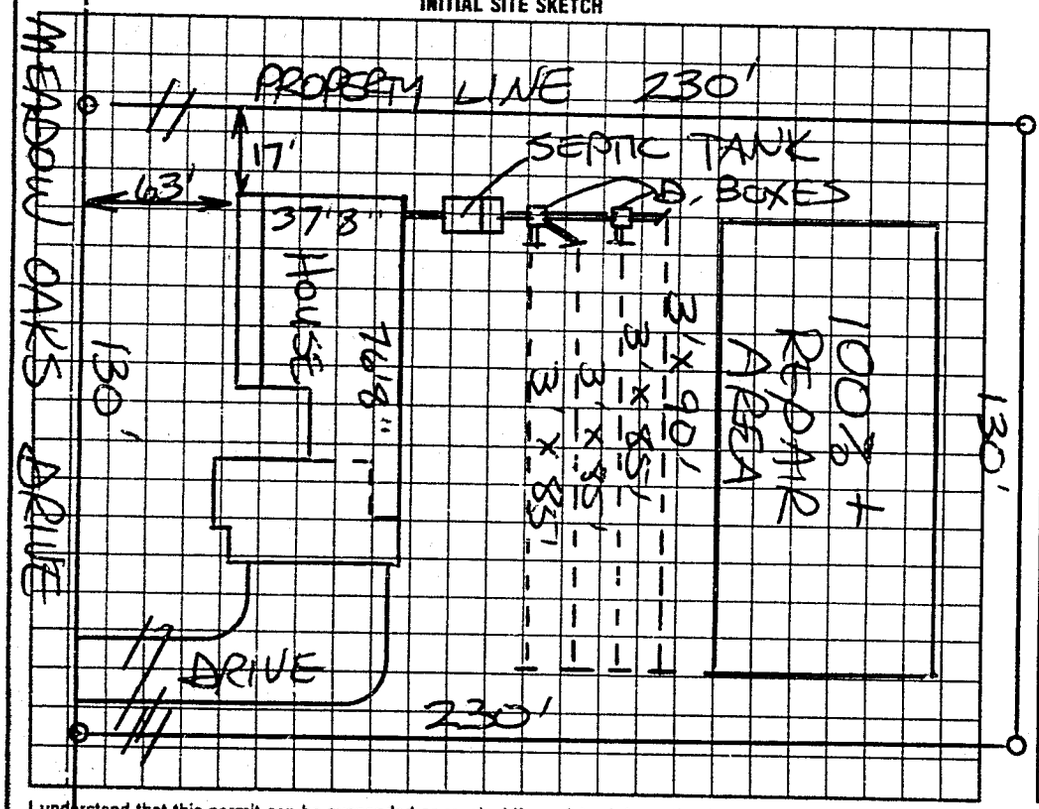

AS BUILT SKETCH

SYSTEM INSTALLED ACCORDING TO INITAL SITE SKETCH

I understand that this permit can be suspended or revoked if any false information is supplied toward securing the permit/any unauthorized changes are made to the site/any unauthorized changes are made in the installation of the system. Improvement Permit is valid for 60 months from date of issuance.

Signed: J. Todd Ellis

Improvement Permit by: STEVE HEDRICK date 3/4/94

Existing System Inspection by: date

Installed by: DAVID YOUNTZ

Certificate of Completion by: STEVE HEDRICK date 7/6/94

Operation Permit by date

HEALTH DEPT. COPY WHITE INSPECTION COPY (FINAL) GREEN OWNER COPY (FINAL) YELLOW INSPECTION COPY (INITIAL) PINK OWNER COPY (INITIAL): GOLD