IREDELL COUNTY HEALTH DEPARTMENT - *ENVIRONMENTAL HEALTH* ☒ STATESVILLE OFFICE 704-878-5305 ☐ MOORESVILLE OFFICE 704-664-5281

IMPROVEMENT PERMIT / AUTHORIZATION TO CONSTRUCT / OPERATION PERMIT / EXISTING SYSTEM INSPECTION

PERMIT # 169061 PIN # 4736-31-8136 DATE 12-20-11

OWNER Billy Hartness APPLICANT: Robert Sharp Const. LLC PHONE: Home/Cell # 704-902-4633 Business #

SITE ADDRESS 119 Meadow Oaks Dr OWNER / APPLICANT ADDRESS

SITE DIRECTIONS 115 N. (R) Sullivan Farm Rd (R) Meadow Oaks Dr. site will be on lft

SUBDIVISION Meadow Oaks BLOCK / SECTION LOT # 31 LOT AREA .65 DESIGN FLOW 360 Ex L.T.A.R. Ex.

Septic Tank Ex. (1000) Gallons: STB Ex (358) Date 1-6-94
Pump Tank Gallons: P T Date
Pump Make Model Serial #
No. Nitrification Fields: 1(ex) No. Lines 4 Linear Feet 345 (ex)
Trench Width 36 (ex) Max. Trench Bottom Depth 36" (ex) Gravel Depth (ex)


☐ New System ☐ Repair ☐ Expansion System Type I (II) III IV V VI
System Description: Existing (Conv. Gravity)
Repair System Description: 50% Reduction
Maintenance Agreement Required ☐ YES ☒ NO
☒ GRAVITY ☐ PRESSURE

☒ Residence No. Bedrooms 3
☐ Business No. Persons
☐ Other No. Employees
☐ Slab ☐ Crawl Space
☐ Basement w/plumbing ☐ Basement w/o plumbing


Water Supply: ☐ Private ☒ Public ☐ Community

Comments / Conditions

INITIAL SITE SKETCH

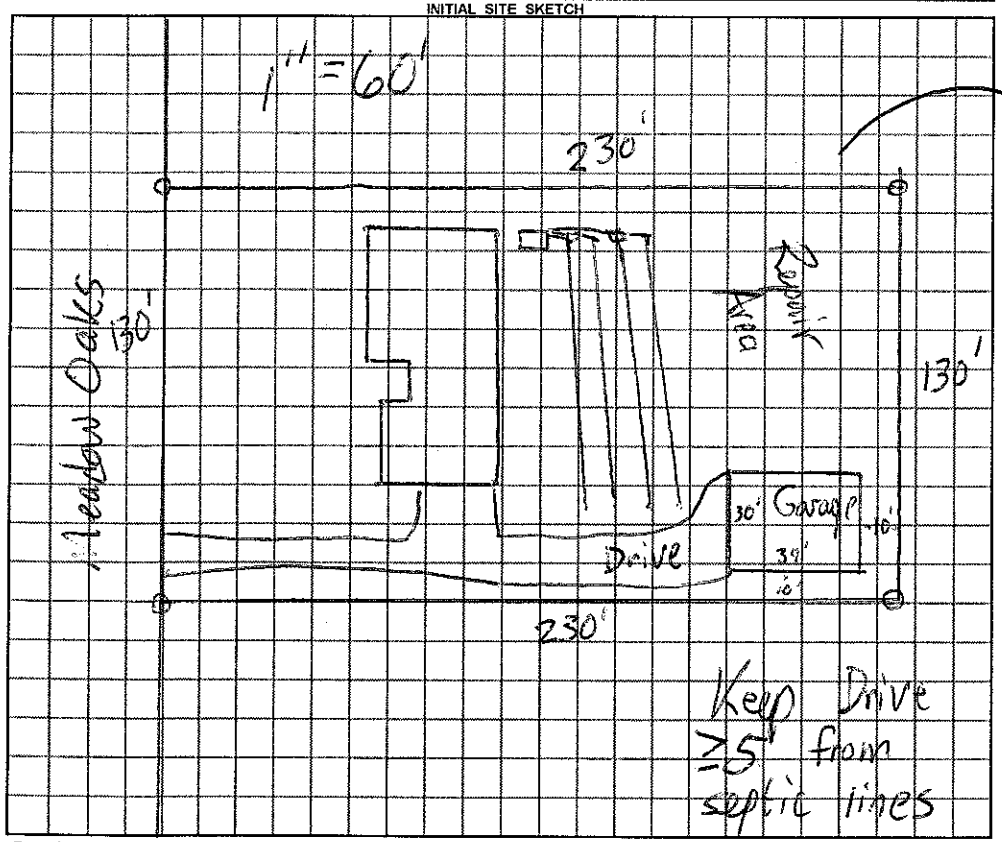

AS BUILT SKETCH

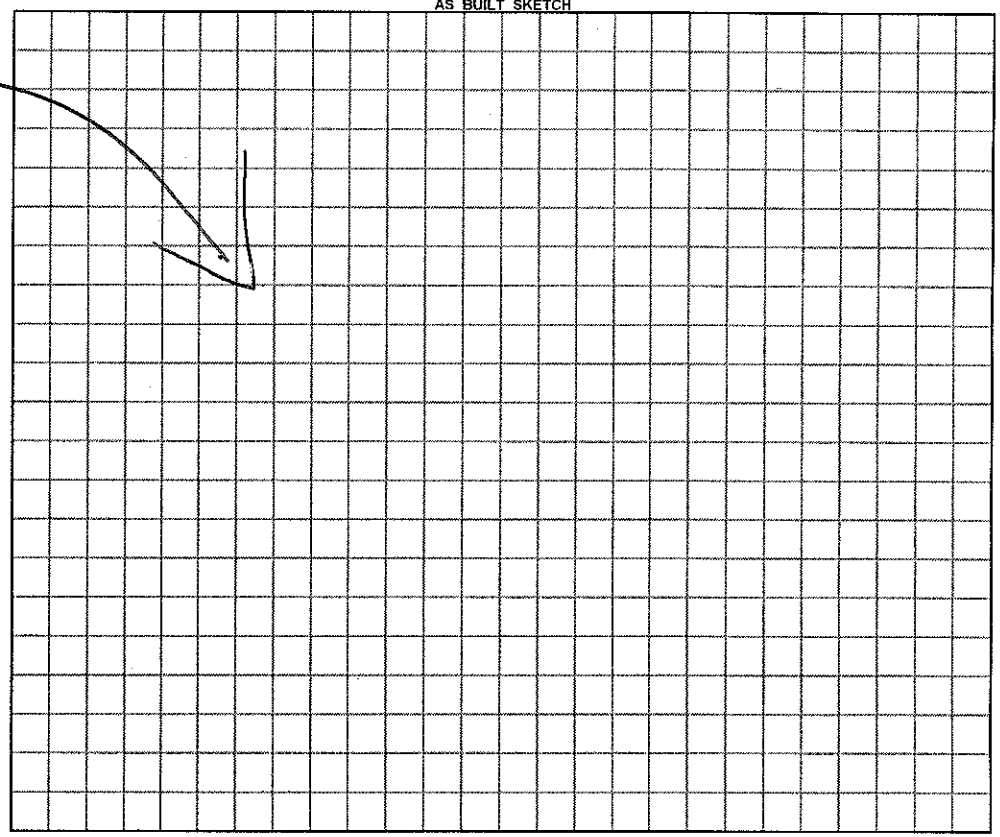

Permit can be suspended or revoked if any false information is supplied toward securing the permit / any unauthorized changes are made to the site / any unauthorized changes are made in the installation of the system.

☐ ***IMPROVEMENT PERMIT*** with plat valid without expiration. ☐ ***IMPROVEMENT PERMIT*** with plat valid without expiration. site plan valid 60 mo. ☐ ***AUTHORIZATION TO CONSTRUCT*** valid for period equal to IMPROVEMENT PERMIT--not to exceed 60 mo.

Owner / Applicant Signature: Date 1/6/12 Installed by:

IMPROVEMENT PERMIT by: REHS Date OPERATION PERMIT by: REHS Date

AUTHORIZATION TO CONSTRUCT by: REHS Date Existing System Inspected by: REHS Date 12-20-11

YOU SHOULD CONTACT A LOCATOR SERVICE PRIOR TO ANY EXCAVATION

White Copy -- Environmental Health YELLOW COPY (Final) Owner / Applicant PINK COPY (Initial) Owner / Applicant