IREDELL COUNTY HEALTH DEPARTMENT

STATESVILLE 704-878-5305 MOORESVILLE 704-664-5281

IMPROVEMENT PERMIT / CERTIFICATE OF COMPLETION / OPERATION PERMIT / EXISTING SYSTEM INSPECTION

PROPERTY DESCRIPTION NO. 22443 DATE 1-12-95 TAX MAP NO. 10D-1-A-30 Watershed: ☐ Yes ☑ No

OWNER OR CONTRACTOR BRAD & NANCY ACK PHONE: Business 881-9463 (MESS) Home 871-0947

ADDRESS 162 KOA LANE #7 STATESVILLE NC 28677

LOCATION NC 115 N, TR SULLIVAN FARM RD, 1ST LOT ON RIGHT PAST MEADOW OAKS DRIVE

SUBDIVISION MEADOW OAKS BLOCK / SECTION ____ LOT 30 LOT AREA ~115'x 310' SITE CLASS P3 DESIGN FLOW 480 L.T.A.R. 0.30 GPD/FT²

Septic Tank: 1000 Gallons; STB 794 Date 2-17-97

Pump Tank: ____ Gallons; PT ____ Date ____

Pump Make: ____ Model ____ Serial No. ____

Nitrification Field: No Fields 1 Square Feet 1600 Linear Feet 533

No Lines 7 Trench Width 36" Max Trench Bottom Depth 18-36" Gravel Depth 12"

☑ New System ☐ Repair System Type: I, II, III, IV, V, VI

System Description: CONVENTIONAL GRAV'S

Repair System Description: CONVENTIONAL PUMP

Maintenance Agreement Required: ☐ Yes ☑ No

☑ House/Mod. Home ☐ Mobile Home ☐ Business ☐ Other

No. Bedrooms 4 No. Bathrooms 2½ No. Employees ____


☐ Slab ☑ Crawl Space ☐ Basement w/plumbing ☐ Basement wo/plumbing

Water Supply: ☐ Individual ☐ Community ☑ Public


Comments:

Comments:

INITIAL SITE SKETCH

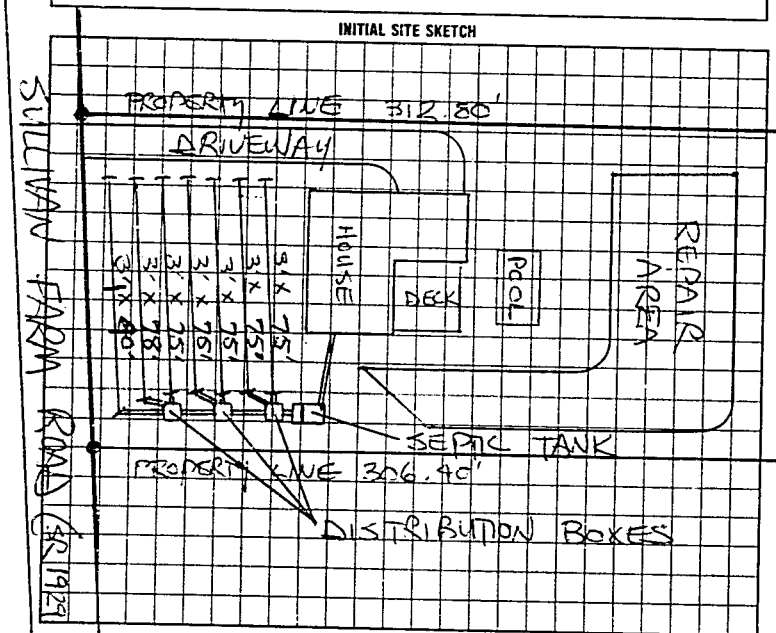

AS BUILT SKETCH

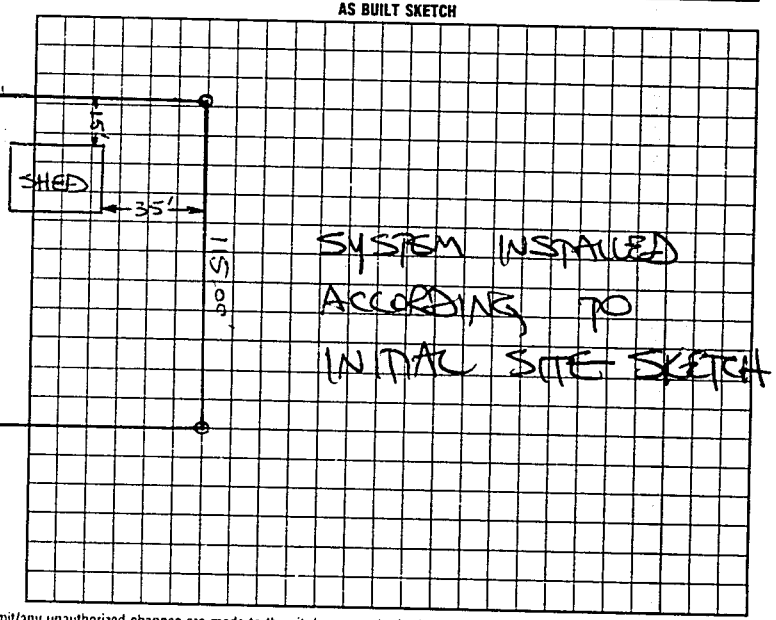

I understand that this permit can be suspended or revoked if any false information is supplied toward securing the permit/any unauthorized changes are made to the site/any unauthorized changes are made in the installation of the system.

AUTHORIZATION TO CONSTRUCT IS VALID FIVE (5) YEARS FROM DATE OF ISSUANCE. IMPROVEMENT PERMIT HAS NO EXPIRATION DATE.

Signed: X [signature]

Improvement Permit by: STEVE HEDRICK date 1-12-95

AUTHORIZATION TO CONSTRUCT ~~Existing System Inspection~~ by: STEVE HEDRICK date 1-12-95

Installed by: ATLANTIC EXCAVATING, (DAN BAKER)

~~Certificate of Completion by:~~ ____ date ____

Operation Permit by: STEVE HEDRICK date 5-1-97

HEALTH DEPT COPY WHITE | INSPECTION COPY (FINAL) GREEN | OWNER COPY (FINAL) YELLOW | INSPECTION COPY (INITIAL) PINK | OWNER COPY (INITIAL) GOLD

0 0 2 2 1 2