PT OF 10D-A-20

IREDELL COUNTY HEALTH DEPARTMENT

STATESVILLE 704-878-5305 MOORESVILLE 704-654-5281

IMPROVEMENT PERMIT / CERTIFICATE OF COMPLETION / OPERATION PERMIT / EXISTING SYSTEM INSPECTION

PROPERTY DESCRIPTION NO. 17533 DATE 5/26/94 TAX MAP NO. 10D-A-20 (51) Watershed: ☐ Yes ☒ No

OWNER OR CONTRACTOR HERITAGE BLDG Co. PHONE: Business 871-7135 Home 528-6644

ADDRESS RT. 10, Box 177-A, STATESVILLE, NC. 28677

LOCATION NC 115 N, TR S. CHIPLEY FORD RD, TL JP'S AT CUL-DE-SAC ON (R)

SUBDIVISION MEADOW OAKS BLOCK / SECTION ____ LOT 51 LOT AREA ~150X360' SITE CLASS. PS DESIGN FLOW 480 L.T.A.R. 0.35 GPD/FT2

Septic Tank: 1000 Gallons; STB 794 Date 7/7/94
Pump Tank: ____ Gallons; PT ____ Date ____
Pump Make: ____ Model ____ Serial No. ____
Nitrification Field: No Fields 2 Square Feet 1380 Linear Feet 460
No Lines 4 Trench Width 36" Max Trench Bottom Depth 18-36" Gravel Depth 12"

☒ New System ☐ Repair System Type: I, (II), III, IV, V, VI
System Description: CONVENTIONAL GRAVITY
Repair System Description: CONV. GRAVITY (PUMP)
Maintenance Agreement Required: ☐ Yes ☒ No

☒ House/Mod. Home ☐ Mobile Home ☐ Business ☐ Other
No. Bedrooms 4 No. Bathrooms 2½ No. Employees ____


☐ Slab ☒ Crawl Space ☐ Basement w/plumbing ☐ Basement wo/plumbing

Water Supply: ☐ Individual ☐ Community ☒ Public

Comments:

Comments:

INITIAL SITE SKETCH

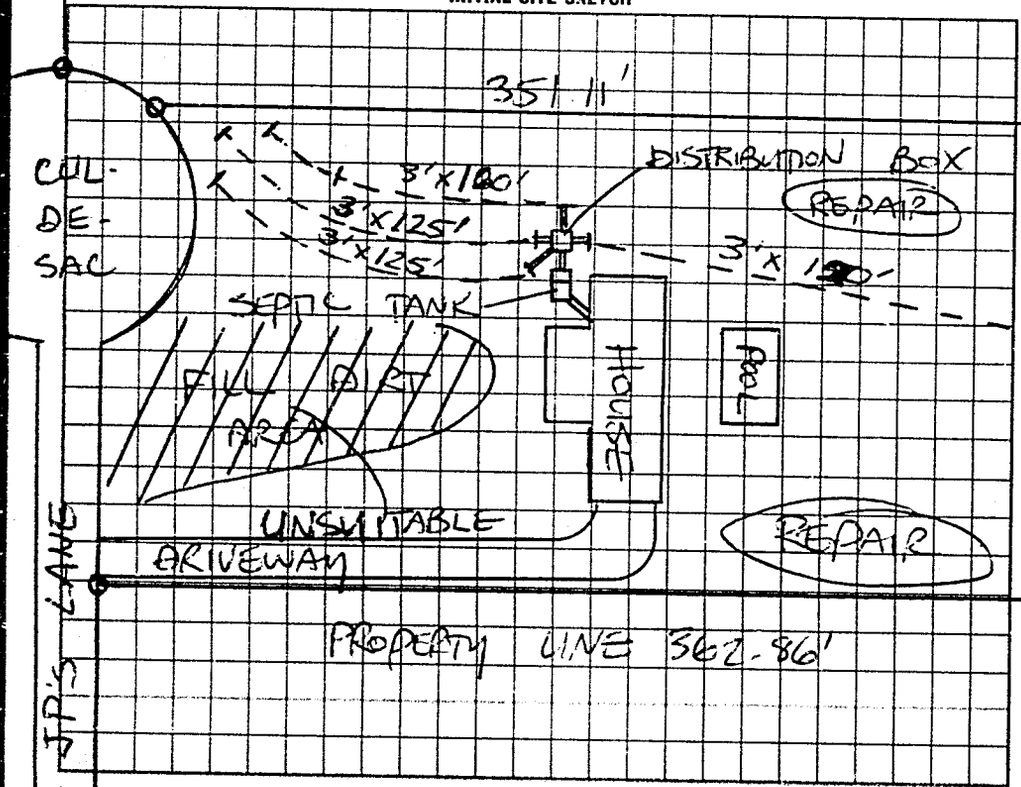

AS BUILT SKETCH

SYSTEM INSTALLED ACCORDING TO INITAL SITE SKETCH

I understand that this permit can be suspended or revoked if any false information is supplied toward securing the permit/any unauthorized changes are made to the site/any unauthorized changes are made in the installation of the system. Improvement Permit is valid for ~~60~~ months from date of issuance.

Signed: [signature]

Improvement Permit by: STEVE HEDRICK date 5/26/94

Existing System Inspection by: ____ date ____

Installed by: WES LYTON

Certificate of Completion by: STEVE HENDRICK date 8/23/94

Operation Permit by: ____ date ____

HEALTH DEPT. COPY: WHITE INSPECTION COPY (FINAL): GREEN OWNER COPY (FINAL): YELLOW INSPECTION COPY (INITIAL): PINK OWNER COPY (INITIAL): GOLD

i20100