IREDELL COUNTY HEALTH DEPARTMENT

STATESVILLE 704-878-5305 MOORESVILLE 704-664-5281

56452

IMPROVEMENT PERMIT / CERTIFICATE OF COMPLETION / OPERATION PERMIT / EXISTING SYSTEM INSPECTION

PROPERTY DESCRIPTION NO. 2146A DATE 6-28-95 TAX MAP NO. 10D-1-A-45 Watershed: ☐ Yes ☑ No

OWNER OR CONTRACTOR J. TODD ELLIS PHONE: Business _____ Home 878-6633

ADDRESS 178 MEADOW OAKS DR STATESVILLE NC 28677

LOCATION NC 115 TR S. CHIPLEY FORD, TL WESTVIEW LN, TL MEADOW OAKS, 4TH LOT ON RIGHT

SUBDIVISION MEADOW OAKS BLOCK / SECTION _____ LOT 45 LOT AREA 130 x 228' SITE CLASS. RS DESIGN FLOW 360 L.T.A.R. 0.30 GPD/FT2

Septic Tank: 1000 Gallons; STB 1012 Date 7-24-95

Pump Tank: _____ Gallons; PT _____ Date _____

Pump Make: _____ Model _____ Serial No. _____

Nitrification Field: No Fields 1 Square Feet 1200 Linear Feet 400

No Lines 4 Trench Width 36" Max Trench Bottom Depth 18-36" Gravel Depth 12"

☑ New System ☐ Repair System Type: I, II, III, IV, V, VI

System Description: CONVENTIONAL GRAVITY

Repair System Description CONV. GRAVITY / PUMP

Maintenance Agreement Required: ☐ Yes ☑ No

☐ Slab ☑ Crawl Space ☐ Basement w/plumbing ☐ Basement wo/plumbing

☐ House/Mod. Home No. Bedrooms 3

☐ Mobile Home No. Bathrooms 2

☐ Business No. Employees _____


☐ Other _____

Water Supply: ☑ Individual ☐ Community ☐ Public

Comments:

Comments:

INITIAL SITE SKETCH

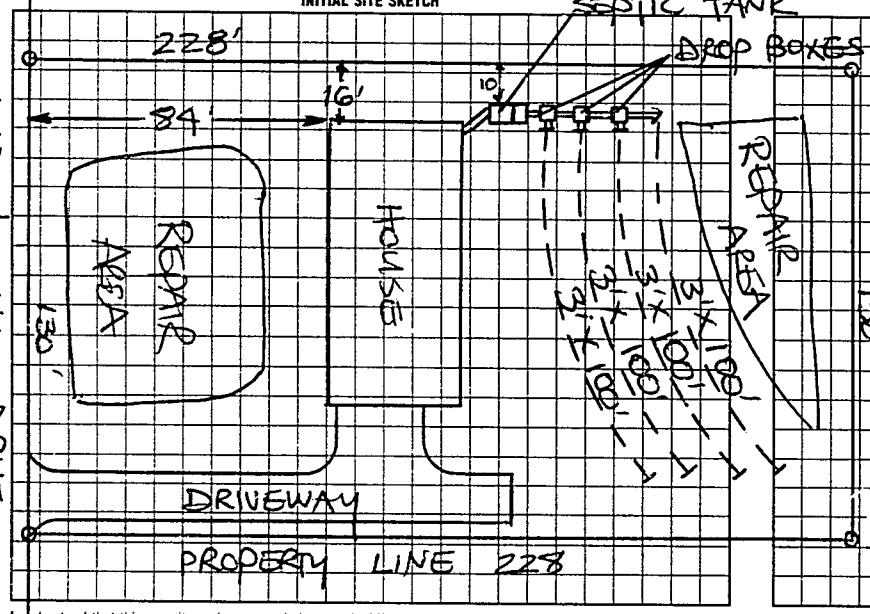

AS BUILT SKETCH

SYSTEM INSTALLED ACCORDING TO INITIAL SITE SKETCH.

I understand that this permit can be suspended or revoked if any false information is supplied toward securing the permit/any unauthorized changes are made to the site/any unauthorized changes are made in the installation of the system. Improvement Permit is valid for 60 months from date of issuance.

Signed: X J. Todd Ellis

Improvement Permit by: STEVE HEDRICK date 6-28-95

Existing System Inspection by: _____ date _____

Installed by: DAVID YOUNTZ

Certification of Completion by: _____ date _____

Operation Permit by: STEVE HEDRICK date 10/10/95

HEALTH DEPT. COPY: WHITE INSPECTION COPY (FINAL): GREEN OWNER COPY (FINAL): YELLOW INSPECTION COPY (INITIAL): PINK OWNER COPY (INITIAL): GOLD

2810002