60600

IREDELL COUNTY HEALTH DEPARTMENT

STATESVILLE 704-878-5305 MOORESVILLE 704-664-5281

IMPROVEMENT PERMIT / CERTIFICATE OF COMPLETION / OPERATION PERMIT / EXISTING SYSTEM INSPECTION

PROPERTY DESCRIPTION NO. 23620 DATE 5-2-96 TAX MAP NO. 10D-1-A-46 Watershed: ☐ Yes ☒ No

OWNER OR CONTRACTOR ALAN LEWIS PHONE: Business Home 878-2305

ADDRESS 488 WHITE OAK BRANCH RD, STATESVILLE, NC 28677

LOCATION NC115 N, JR S. CHIPLEY FORD RD, TL WESTVIEW LANE, TL MEADOW OAKS DR, 3RD LOT ON RIGHT

SUBDIVISION MEADOW OAKS BLOCK / SECTION ____ LOT 46 LOT AREA 130' x 228' SITE CLASS. PS DESIGN FLOW 360 L.T.A.R. 0.30 GPD/FT²

Septic Tank: 1000 Gallons, STB 1012 Date 6-1-96

Pump Tank: ____ Gallons; PT ____ Date ____

Pump Make: ____ Model ____ Serial No. ____

Nitrification Field: No Fields 1 Square Feet 1200 Linear Feet 400

No Lines 4 Trench Width 36" Max Trench Bottom Depth 18-30" Gravel Depth 12"

☒ New System ☐ Repair System Type: I (II) III IV V VI

System Description: CONVENTIONAL GRAVITY

Repair System Description: CONVENTIONAL GRAVITY

Maintenance Agreement Required: ☐ Yes ☒ No

☒ House/Mod. Home No. Bedrooms 3

☐ Mobile Home No. Bathrooms 2

☐ Business No. Employees ____

☐ Other ____


☐ Slab ☒ Crawl Space ☐ Basement w/plumbing ☐ Basement wo/plumbing

Water Supply:
☐ Individual
☐ Community
☒ Public

Comments:

Comments:

INITIAL SITE SKETCH

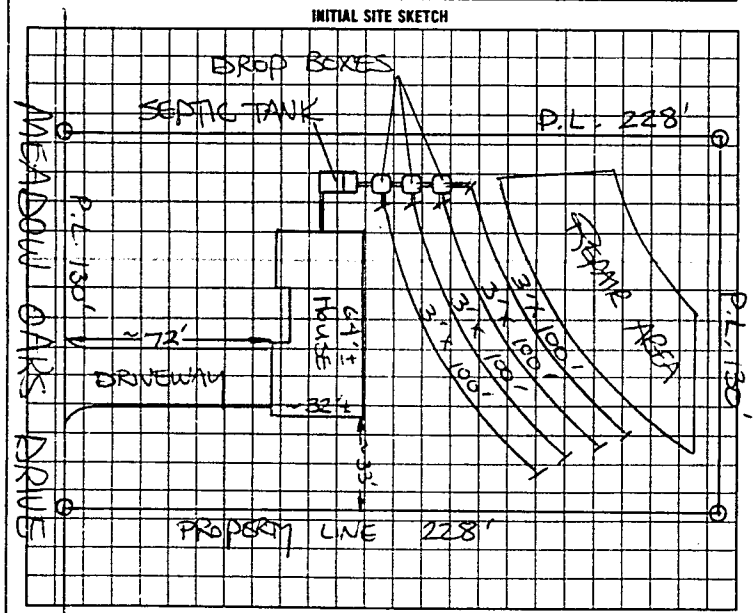

AS BUILT SKETCH

SYSTEM INSTALLED ACCORDING TO INITIAL SITE SKETCH

I understand that this permit can be suspended or revoked if any false information is supplied toward securing the permit/any unauthorized changes are made to the site/any unauthorized changes are made in the installation of the system. Authorization to Construct is valid five (5) years from date of issuance. Improvement Permit has no expiration date.

Signed: Alan Lewis

Improvement Permit by: STEVE HEDRICK date 5-2-96

AUTHORIZATION TO CONSTRUCT: STEVE HEDRICK date 5-2-96

Installed by: Tommy Frye

Certificate of Completion by: ____ date ____

Operation Permit by STEVE HEDRICK date 9-9-96

HEALTH DEPT COPY WHITE | INSPECTION COPY (FINAL) GREEN | OWNER COPY (FINAL) YELLOW | INSPECTION COPY (INITIAL) PINK | OWNER COPY (INITIAL) GOLD

102100