55594

IREDELL COUNTY HEALTH DEPARTMENT

STATESVILLE 704-878-5305 MOORESVILLE 704-664-5281

IMPROVEMENT PERMIT / CERTIFICATE OF COMPLETION / OPERATION PERMIT / EXISTING SYSTEM INSPECTION

PROPERTY DESCRIPTION NO. 19617 DATE 4/20/95 TAX MAP NO. 10A-1-A-47 Watershed: ☐ Yes ☒ No

OWNER OR CONTRACTOR ALAN LEWIS PHONE: Business Home 878-2305

ADDRESS 488 WHITE OAK BRANCH RD STATESVILLE, NC 28677

LOCATION NC 115 N, JR CRIPPEN RD RD TL WESTVIEW LN, TL MEADOW OAKS DR, 2ND LOT ON R

SUBDIVISION MEADOW OAKS BLOCK / SECTION LOT 47 LOT AREA 130' X 228' SITE CLASS. PS DESIGN FLOW 360 L.T.A.R. 0.30 GPD/FT2

Septic Tank: 1000 Gallons; STB 1012 Date 6-17-95

Pump Tank: Gallons; PT Date

Pump Make: Model Serial No.

Nitrification Field: No Fields 1 Square Feet 1200 Linear Feet 400

No Lines 4 Trench Width 36" Max Trench Bottom Depth 18-30" Gravel Depth 12

☒ New System ☐ Repair System Type: I II III IV V VI

System Description: CONVENTIONAL GRAVITY

Repair System Description: CONV. GRAVITY

Maintenance Agreement Required: ☐ Yes ☒ No

☒ House/Mod. Home No. Bedrooms 3

☐ Mobile Home No. Bathrooms 2

☐ Business No. Employees

☐ Other


☐ Slab ☒ Crawl Space ☐ Basement w/plumbing ☐ Basement wo/plumbing

Water Supply:
☐ Individual
☐ Community
☒ Public

Comments: TRENCH DEPTH NO GREATER THAN 30"

Comments:

INITIAL SITE SKETCH

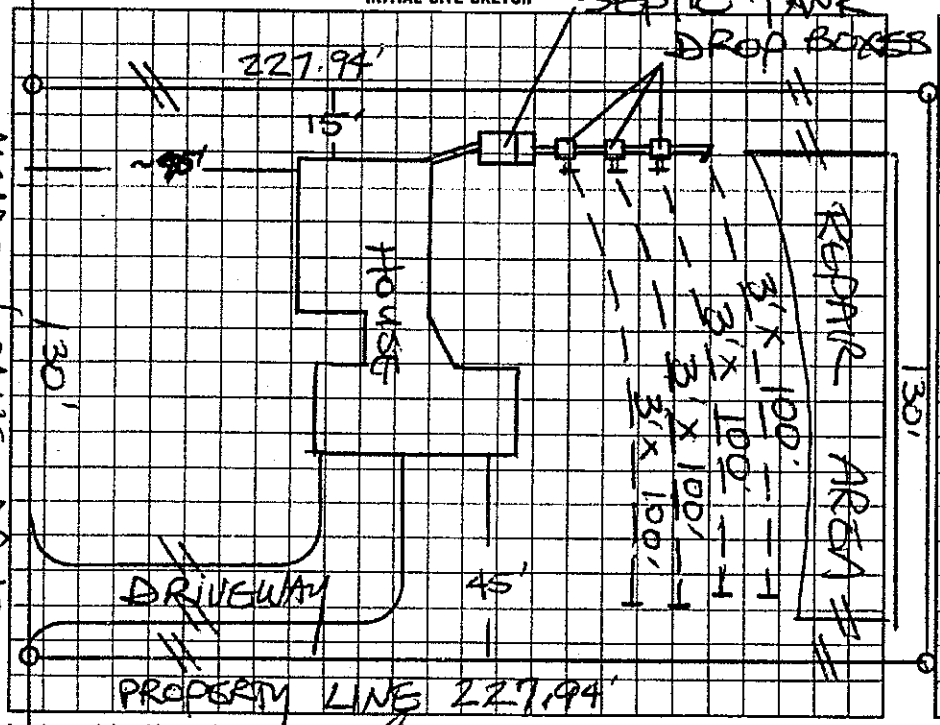

AS BUILT SKETCH

SYSTEM INSTALLED ACCORDING TO INITIAL SITE SKETCH

Location of the proposed SUNROOM & DECK addition does not appear to impact the existing on-site septic system.**NOTE: KEEP MIN. 5' FROM SYSTEM

R. STEVE HENDRICK REHS

Date: SEPT. 8, 2011

ICHD-Environmental Health Division

I understand that this permit can be suspended or revoked if any false information is supplied toward securing the permit/any unauthorized changes are made to the site/any unauthorized changes are made in the installation of the system. Improvement Permit is valid for 60 months from date of issuance.

Signed: Alan Lewis

Improvement Permit by: STEVE HENDRICK date 4/20/95

Existing System Inspection by: date

Installed by: TOMMY FRYE

Certificate of Completion by: STEVE HENDRICK date 9-1-95

Operation Permit by: date

HEALTH DEPT. COPY: WHITE INSPECTION COPY (FINAL): GREEN OWNER COPY (FINAL): YELLOW INSPECTION COPY (INITIAL): PINK OWNER COPY (INITIAL): GOLD