IREDELL COUNTY HEALTH DEPARTMENT

STATESVILLE 704-878-5305 MOORESVILLE 704-664-5281

IMPROVEMENT PERMIT / AUTHORIZATION TO CONSTRUCT / OPERATION PERMIT / EXISTING SYSTEM INSPECTION

PERMIT # 176147 Repair PIN # 4736402795 DATE 12/4/12

OWNER or APPLICANT Alvie Plyler PHONE: Business 704-872-4906 Home:

OWNER or APPLICANT ADDRESS 130 Westview Lane

LOCATION / DIRECTIONS 115 N (R) on S Chipley Ford, 1.5 miles left on Westview Ln. 2nd home on right.

SUBDIVISION Meadow Oak BLOCK / SECTION 1 LOT # 52 LOT AREA 150x362 DESIGN FLOW 360 L.T.A.R. Ex.

Septic Tank 1000 Gallons: STB 760 Date 5-10-12

Pump Tank ____ Gallons: P T ____ Date ____

Pump Make ____ Model ____ Serial # ____

Nitrification Field No Fields 1 No Lines Ex Linear Feet Ex

Trench Width Ex Max. Trench Bottom Depth Ex Gravel Depth Ex

☐ New System ☒ Repair ☒ Expansion System Type I (II) III IV V VI

System Description: ____

Repair System Description: TANK

Maintenance Agreement Required ☐ YES ☒ NO

☐ GRAVITY ☐ PRESSURE

☒ Residence No. Bedrooms 3

☐ Business No. Persons ____

☐ Other No. Employees ____

☐ Slab ☒ Crawl Space


☐ Basement w/plumbing ☐ Basement w/o plumbing

Water Supply: ☐ Private ☒ Public ☐ Community


Comments / Conditions

Comments / Conditions

INITIAL SITE SKETCH

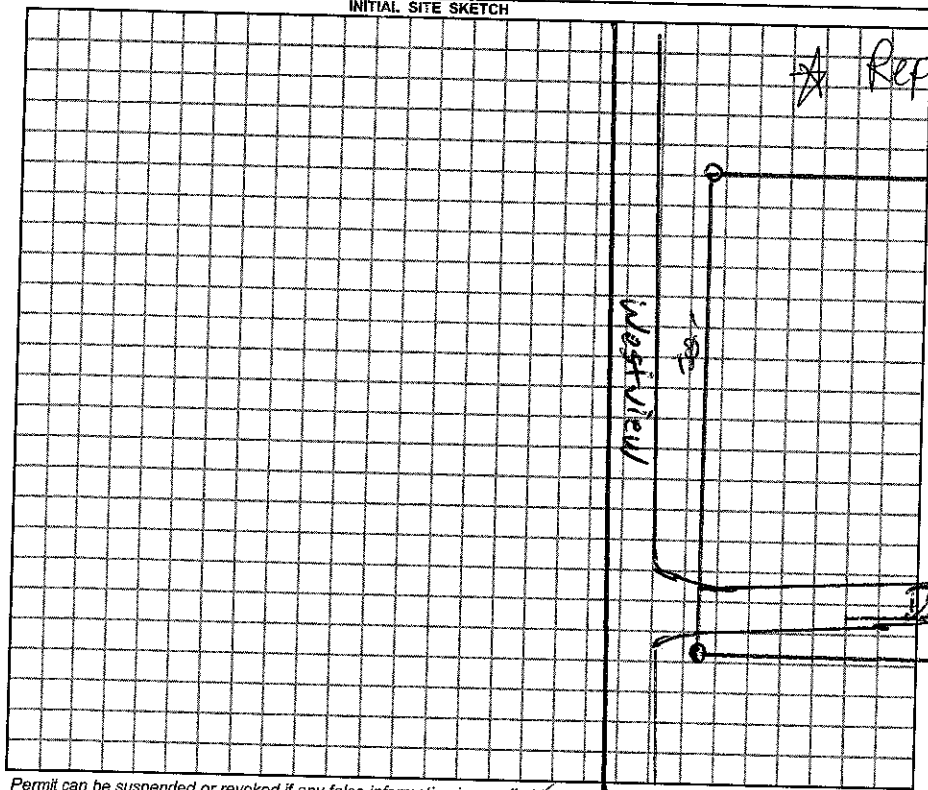

AS BUILT SKETCH

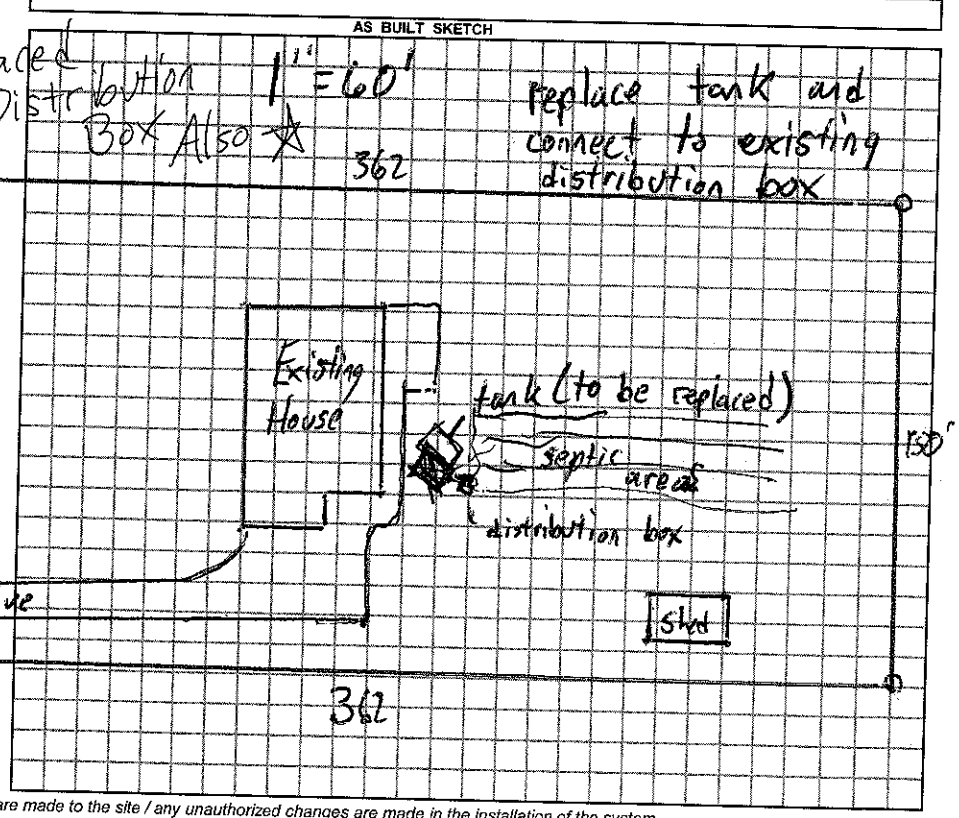

Permit can be suspended or revoked if any false information is supplied toward securing the permit / any unauthorized changes are made to the site / any unauthorized changes are made in the installation of the system.

☐ *IMPROVEMENT PERMIT w / plat valid without expiration* ☒ *IMPROVEMENT PERMIT w / site plan valid for 60 mos.* ☒ *AUTHORIZATION TO CONSTRUCT valid for period equal to IMPROVEMENT PERMIT-not to exceed 60 mo.*

Owner / Applicant Signature: Alvie Plyler Date 12-4-12

Improvement Permit by: James Date 12-4-12

Authorization to Construct by: James Date 12-4-12

YOU SHOULD CONTACT A LOCATOR SERVICE PRIOR TO ANY EXCAVATION.

Installed by: A-1 Backhoe

Operation Permit by: James Date: 12-6-12

Existing System Inspected by: ____ Date: ____

WHITE COPY Environmental Health YELLOW COPY (Final) Owner / Applicant PINK COPY (Initial) Owner / Applicant