IREDELL COUNTY HEALTH DEPARTMENT

STATESVILLE 704-878-5305 MOORESVILLE 704-664-5281

IMPROVEMENT PERMIT / AUTHORIZATION TO CONSTRUCT / OPERATION PERMIT / EXISTING SYSTEM INSPECTION

PERMIT # 15926 PIN # 4736-46-2795 DATE 7-13-09

OWNER or APPLICANT Alvie & Barbara Plyler PHONE: Business Home:

OWNER or APPLICANT ADDRESS 130 Westview LN Statesville 28625

LOCATION / DIRECTIONS Meadow Oaks → 130 Westview Lane

SUBDIVISION Meadow Oaks BLOCK / SECTION LOT # 52 LOT AREA 150 X 362 DESIGN FLOW 360 L.T.A.R.

Existing

Septic Tank 1000 Gallons: STB 1012 Date 7-16-96

Pump Tank Gallons: P T Date

Pump Make Model Serial #

Nitrification Field No Fields No Lines 3 Linear Feet 300

Trench Width 36" Max. Trench Bottom Depth 30" Gravel Depth 18-36

☑ New System ☐ Repair ☐ Expansion System Type I II III IV V VI

System Description Conventional Gravity

Repair System Description: 25% Expansion

Maintenance Agreement Required ☐ YES ☐ NO

☑ GRAVITY ☐ PRESSURE

☑ Residence No. Bedrooms 3

☐ Business No. Persons

☐ Other No. Employees

☐ Slab ☐ Crawl Space


☐ Basement w/plumbing ☐ Basement w/o plumbing

Water Supply: ☐ Private ☑ Public ☐ Community

Comments / Conditions

Comments / Conditions

INITIAL SITE SKETCH

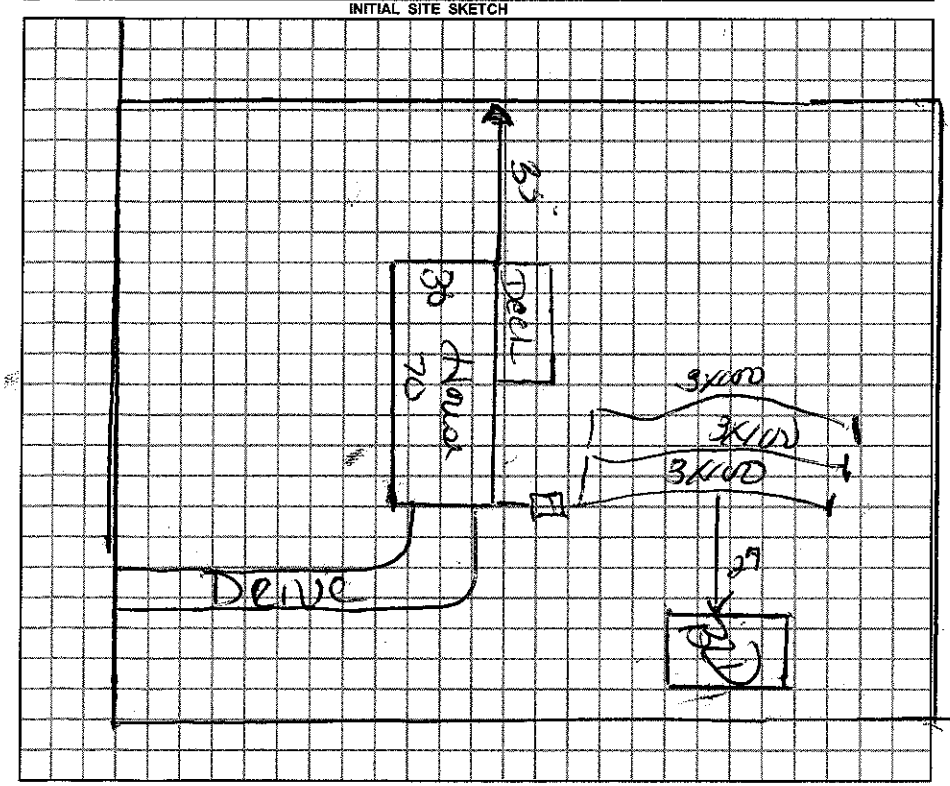

AS BUILT SKETCH

Building does not encroach on septic

Permit can be suspended or revoked if any false information is supplied toward securing the permit / any unauthorized changes are made to the site / any unauthorized changes are made in the installation of the system.

☐ *IMPROVEMENT PERMIT w / plat valid without expiration.* ☐ *IMPROVEMENT PERMIT w / site plan valid for 60 mos.* ☑ *AUTHORIZATION TO CONSTRUCT valid for period equal to IMPROVEMENT PERMIT-not to exceed 60 mo.*

Owner / Applicant Signature: Date

Improvement Permit by: Kyle Cox Date 7-13-09

Authorization to Construct by: Kyle Cox Date 7-13-09

YOU SHOULD CONTACT A LOCATOR SERVICE PRIOR TO ANY EXCAVATION.

Installed by:

Operation Permit by: Date:

Existing System Inspected by: Kyle Cox Date: 7-13-09

WHITE COPY Environmental Health YELLOW COPY (Final) Owner / Applicant PINK COPY (Initial) Owner / Applicant