IREDELL COUNTY HEALTH DEPARTMENT

STATESVILLE 704-878-5305 MOORESVILLE 704-664-5281

IMPROVEMENT PERMIT / AUTHORIZATION TO CONSTRUCT / OPERATION PERMIT / EXISTING SYSTEM INSPECTION

PERMIT# 094099 PIN# 4736 40 5204 DATE 2-3-01

OWNER OR CONTRACTOR EARL LINDERMAN PHONE: Business Home 872-5370

ADDRESS 499 EUFOLA ROAD, STATESVILLE, NC 28677

LOCATION NC 115 N, TR 5, CHIPLEY FORD, TL WESTVIEW LN, TL MEADOW OAKS DR, 2ND LOT ON LEFT

SUBDIVISION MEADOW OAKS BLOCK / SECTION I LOT 5 LOT AREA 0.728 ACRE SITE CLASS PS DESIGN FLOW 480 L.T.A.R. 0.30 GPD/FT²

Septic Tank: 1000 Gallons; STB 10/2 Date 3-26-01
Pump Tank: Gallons; PT Date
Pump Make: Model Serial No.
Nitrification Field: No Fields 1 Square Feet EA. TO 1600 Linear Feet 400 T
No Lines FOUR Trench Width 36" Max Trench Bottom Depth 36" Gravel Depth N/A

☑ New System ☐ Repair System Type: I, II, III, IV, V, VI
System Description: 25% REDUCTION, GRAVITY
Repair System Description: 50% REDUCTION, LOW PRESS
Maintenance Agreement Required: ☐ Yes ☑ No

☑ House/Mod. Home No. Bedrooms 4
☐ Mobile Home No. Bathrooms 2½
☐ Business No. Employees
☐ Other


☐ Slab ☐ Crawl Space ☐ Basement w/plumbing ☐ Basement wo/plumbing

Water Supply: ☐ Individual ☑ Public ☐ Community

Comments/Conditions: INSTALL 25% REDUCTION SYSTEM USING SIXTY-SEVEN (67) CHAMBERS OR FORTY (40) HDS SECTIONS AS PLACED

Comments/Conditions: - Polok filter
- Tank Risers - Installed
- InFiltrator Chambers Installed (67)

SCALE: 1"=40' INITIAL SITE SKETCH

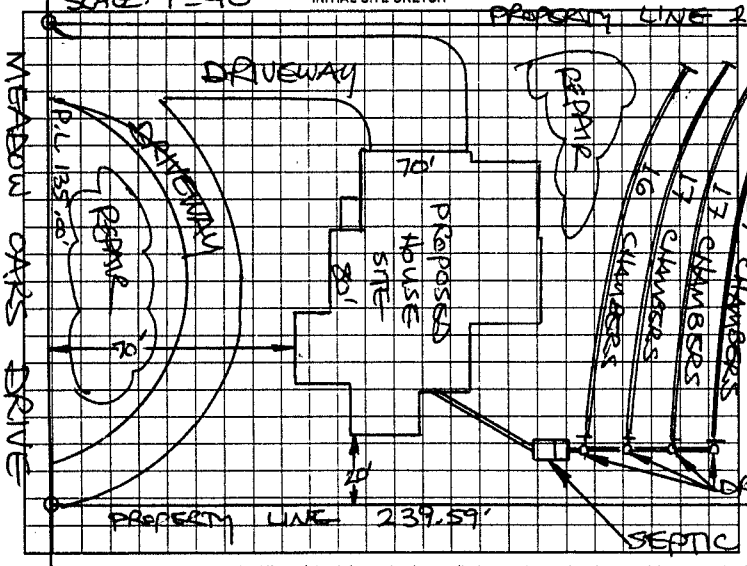

AS BUILT SKETCH

Installed as shown per Initial Site Sketch

Permit can be suspended or revoked if any false information is supplied toward securing the permit/any unauthorized changes are made to the site/any unauthorized changes are made in the installation of the system. Improvement Permit with plat valid without expiration. Improvement Permit with site plan valid for sixty months. Authorization to Construct is valid for a period equal to that of Improvement Permit – not to exceed sixty months.

Signed: David A. Bury date 2.6.01 Installed by: A-1 Backhoe

Improvement Permit by: STEVE HEDRICK date 2-3-01 Operation Permit by: [illegible] O. Gwinner date 6-4-01

Authorization to Construct by: STEVE HEDRICK date 2-3-01 Existing System Inspection by: date

HEALTH DEPT. COPY: WHITE OWNER COPY (FINAL): YELLOW OWNER COPY (INITIAL): PINK