IREDELL COUNTY HEALTH DEPARTMENT

STATESVILLE 704-878-5305 MOORESVILLE 704-664-5281

IMPROVEMENT PERMIT / CERTIFICATE OF COMPLETION / OPERATION PERMIT / EXISTING SYSTEM INSPECTION

PROPERTY DESCRIPTION NO. 069512 DATE 9-25-97 TAX MAP NO. 4736405400 Watershed: ☐ Yes ☐ No

OWNER OR CONTRACTOR Sam Scott PHONE: Business _____ Home 873 1321

ADDRESS 2278 S Chipley Ford Rd Statesville

LOCATION Chipley Ford Rd Lt Westview on Lt at corner

SUBDIVISION Meadow Oaks BLOCK / SECTION _____ LOT 4 LOT AREA 0.99 SITE CLASS. P/S DESIGN FLOW 480 L.T.A.R. 0.3

Septic Tank: 1000 Gallons; STB 612 Date 10-6-97

Pump Tank: _____ Gallons; PT _____ Date _____

Pump Make. _____ Model _____ Serial No. _____

Nitrification Field: No Fields 1 Square Feet 1600 Linear Feet 533

No Lines 4 Trench Width 36in Max Trench Bottom Depth 36in Gravel Depth 12in

☒ New System ☐ Repair System Type: I, (II), III, IV, V, VI

System Description: Gravity Conventional

Repair System Description: Rep/Gravity Chamber

Maintenance Agreement Required: ☐ Yes ☐ No

☒ House/Mod. Home ☐ Mobile Home ☐ Business ☐ Other

No. Bedrooms 4 No. Bathrooms 3 No. Employees _____


☐ Slab ☒ Crawl Space ☐ Basement w/plumbing ☐ Basement wo/plumbing

Water Supply: ☐ Individual ☐ Community ☒ Public

Comments: Keep lines on Contour, 9ft on center Smoothout Terrace

Comments:

INITIAL SITE SKETCH 194

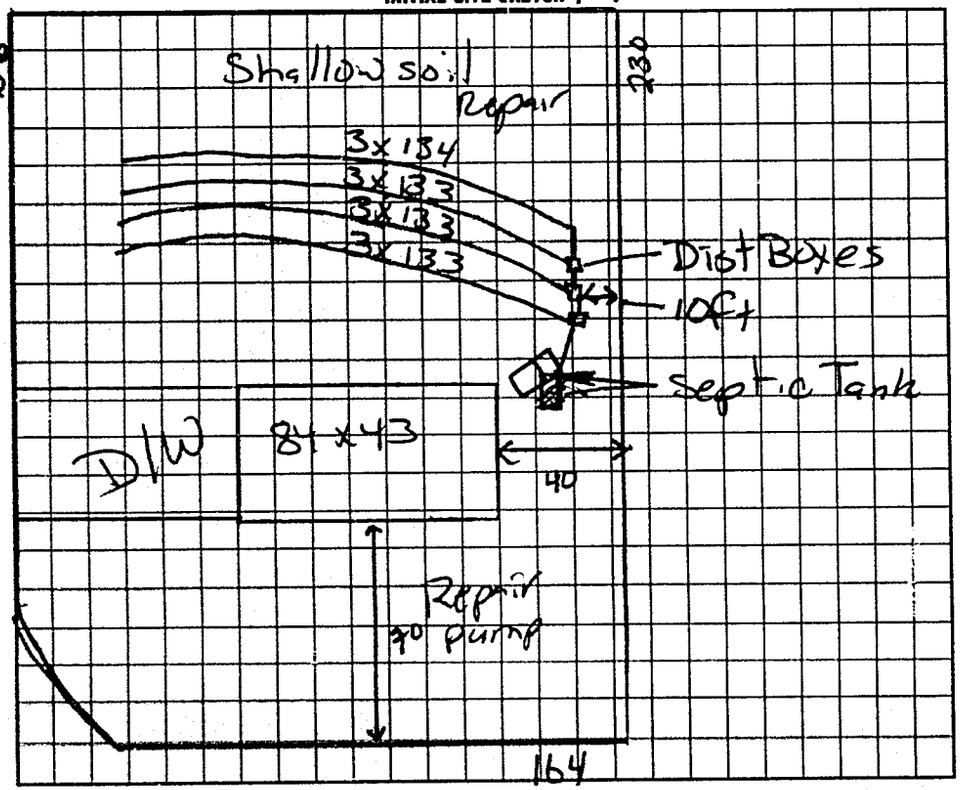

AS BUILT SKETCH

SYSTEM INSTALLED ACCORDING TO INITIAL SITE SKETCH

I understand that this permit can be suspended or revoked if any false information is supplied toward securing the permit/any unauthorized changes are made to the site/any unauthorized changes are made in the installation of the system. Improvement Permit is valid for 60 months from date of issuance.

Signed: Samuel A. Scott

Improvement Permit by: Mark Coffey date 9-25-97

Authorization to Construct Existing System Inspection by: Mark Coffey date 9-25-97

Installed by: DAVID YOUNTZ

Certificate of Completion by: STEVE HEDRICK date 1-30-98

Operation Permit by: _____ date _____

HEALTH DEPT. COPY: WHITE INSPECTION COPY (FINAL): GREEN OWNER COPY (FINAL): YELLOW INSPECTION COPY (INITIAL): PINK OWNER COPY (INITIAL): GOLD