10D-1-A-3 56890

IREDELL COUNTY HEALTH DEPARTMENT

STATESVILLE 704-878-5305 MOORESVILLE 704-664-5281

IMPROVEMENT PERMIT / CERTIFICATE OF COMPLETION / OPERATION PERMIT / EXISTING SYSTEM INSPECTION

PROPERTY DESCRIPTION NO. 17532 DATE 7-24-95 TAX MAP NO. 10D-A-20 (3) (PART) Watershed: ☐ Yes ☑ No

OWNER OR CONTRACTOR HERITAGE BLDG. CO. PHONE: Business Home 528-6644

ADDRESS RT. 10 BOX 171-A STATESVILLE, NC 28677

LOCATION NC 115 N TR 3 SHIPLEY FORD, T- WESTVIEW LANE, 2ND LOT ON LEFT

SUBDIVISION MEADOW OAKS BLOCK / SECTION LOT 3 LOT AREA AMPLE SITE CLASS. PS DESIGN FLOW 360 L.T.A.R. 0.3 GPD/FT

Septic Tank: 1000 Gallons; STB 1012 Date 8-12-95

Pump Tank: Gallons; PT Date

Pump Make: Model Serial No.

Nitrification Field: No Fields 1 Square Feet 1280 Linear Feet 400

No Lines 3 Trench Width 36" Max Trench Bottom Depth 18-36 Gravel Depth 12"

☑ New System ☐ Repair System Type: I, II, III, IV, V, VI

System Description: CONVENTIONAL GRAVITY

Repair System Description: CONV. GRAVITY

Maintenance Agreement Required: ☐ Yes ☑ No

☐ Slab ☑ Crawl Space ☐ Basement w/plumbing ☐ Basement wo/plumbing

☑ House/Mod. Home No. Bedrooms 3

☐ Mobile Home No. Bathrooms 2

☐ Business No. Employees


☐ Other

Water Supply: ☐ Individual ☐ Community ☑ Public


Comments: ① KEEP SYSTEM MINIMUM 15' FROM POOL ② INSTALL LINES ON CONTOUR, NO DEEPER THAN 36"

Comments:

INITIAL SITE SKETCH

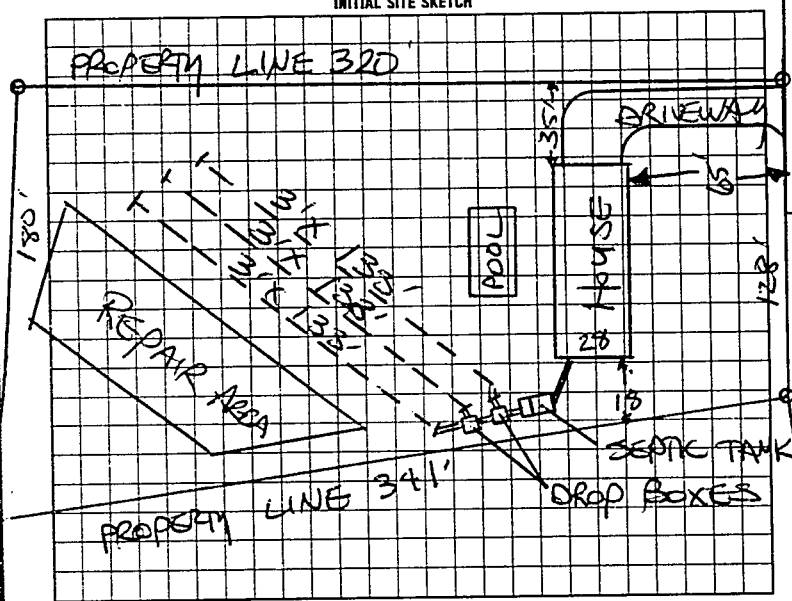

AS BUILT SKETCH

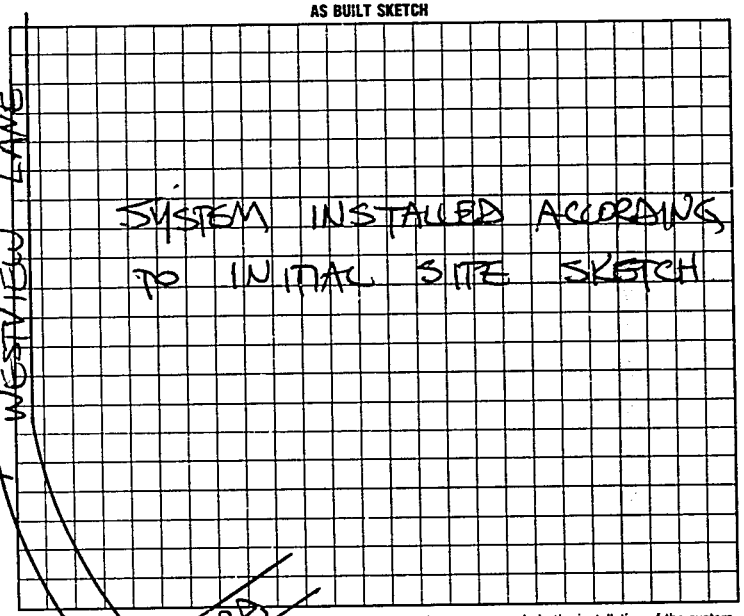

I understand that this permit can be suspended or revoked if any false information is supplied toward securing the permit/any unauthorized changes are made to the site/any unauthorized changes are made in the installation of the system. Improvement Permit is valid for 60 months from date of issuance.

Signed: [signature] Installed by: TOMMY FRYE

Improvement Permit by: STEVE HEDRICK date 7-24-95 Certificate of Completion by: STEVE HEDRICK date 10-11-95

Existing System Inspection by: date Operation Permit by: date

HEALTH DEPT. COPY: WHITE INSPECTION COPY (FINAL): GREEN OWNER COPY (FINAL): YELLOW INSPECTION COPY (INITIAL): PINK OWNER COPY (INITIAL): GOLD

FOR 5' BOX

0 S 9 0 0 0