IREDELL COUNTY HEALTH DEPARTMENT

STATESVILLE 704-878-5305 MOORESVILLE 704-664-5281

IMPROVEMENT PERMIT / CERTIFICATE OF COMPLETION / OPERATION PERMIT / EXISTING SYSTEM INSPECTION

PROPERTY DESCRIPTION NO. 70744 DATE 12-12-97 TAX MAP NO. 4736 40 8463 Watershed: ☐ Yes ☐ No

OWNER OR CONTRACTOR Kenneth Waff PHONE: Business _____ Home _____

ADDRESS 129 Beckham Rd Statesville

LOCATION 2155 Chipley Fork Rd 115N Jct Chipley Ft Rd Past Ft Dobbs Rd 1st lot left

SUBDIVISION meadow oaks BLOCK / SECTION _____ LOT 1 LOT AREA .99 acres SITE CLASS. PS DESIGN FLOW 360 L.T.A.R. .13

Septic Tank: 1000 Gallons; STB 1012 Date 2-11-98

Pump Tank: _____ Gallons; PT _____ Date _____

Pump Make: _____ Model _____ Serial No. _____

Nitrification Field: No Fields 1 Square Feet 1200 Linear Feet 400

No Lines 4 Trench Width 36" Max Trench Bottom Depth 36" Gravel Depth 12"

☑ New System ☐ Repair System Type: I, II, III, IV, V, VI

System Description: Conv. Gravity

Repair System Description Gravity chambers or HDPE

Maintenance Agreement Required: ☐ Yes ☑ No

☑ House/Mod. Home No. Bedrooms 3

☐ Mobile Home No. Bathrooms 2

☐ Business No. Employees _____

☐ Other _____

☐ Slab ☑ Crawl Space ☐ Basement w/plumbing ☐ Basement wo/plumbing


Water Supply: ☐ Individual ☐ Community ☑ Public

Comments:

Grade off small terrace in area of drain lines

Comments:

INITIAL SITE SKETCH

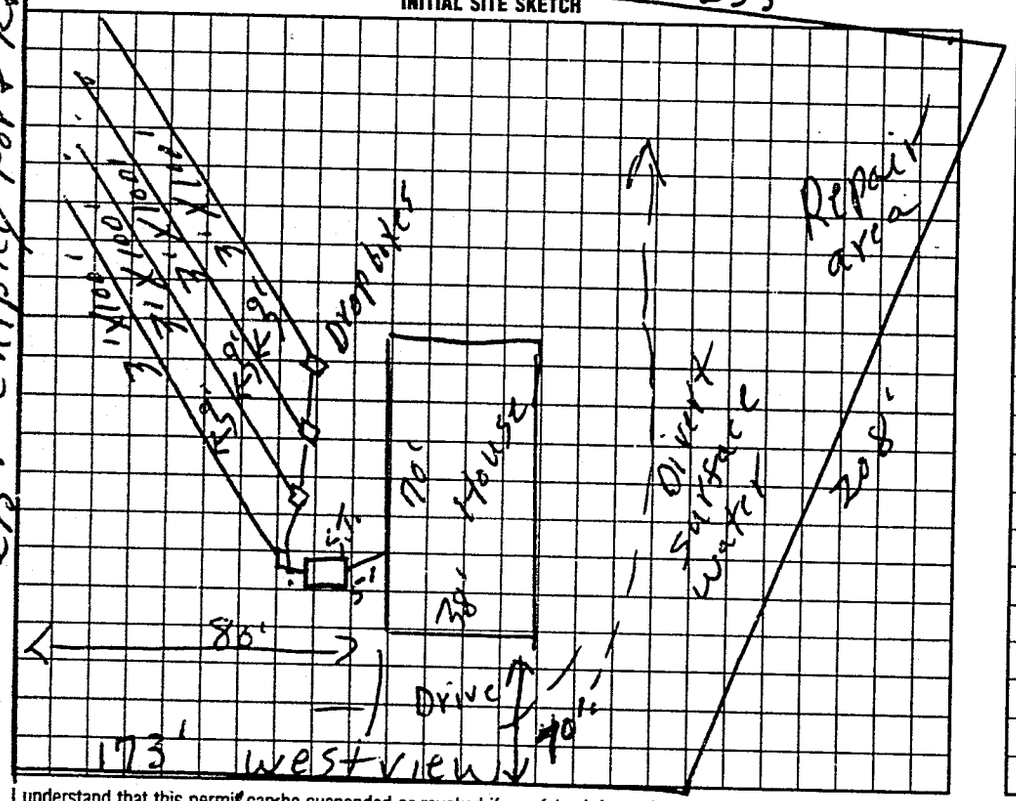

AS BUILT SKETCH

Installed as shown

I understand that this permit can be suspended or revoked if any false information is supplied toward securing the permit/any unauthorized changes are made to the site/any unauthorized changes are made in the installation of the system. Improvement Permit is valid for 60 months from date of issuance.

Signed: X Kenneth Waff

Improvement Permit by: P.C. Moore date 12-12-97

Existing System Inspection by: P.C. Moore date 2-12-98

Installed by: David Yantz

Certificate of Completion by: _____ date _____

Operation Permit by: Mary Coutts RS date 4-14-98

HEALTH DEPT. COPY: WHITE INSPECTION COPY (FINAL): GREEN OWNER COPY (FINAL): YELLOW INSPECTION COPY (INITIAL): PINK OWNER COPY (INITIAL): GOLD

Authorization to Count

Authorization to Count EXPIRES 60 MOS FROM ISSUE