IREDELL COUNTY HEALTH DEPARTMENT

STATESVILLE 704-878-5305 MOORESVILLE 704-664-5281

IMPROVEMENT PERMIT / CERTIFICATE OF COMPLETION / OPERATION PERMIT / EXISTING SYSTEM INSPECTION

PROPERTY DESCRIPTION NO. 67830 DATE 6-4-97 TAX MAP NO. 4736 41 3359 Watershed: ☐ Yes ☐ No

OWNER OR CONTRACTOR J. Todd Ellis PHONE: Business 704 878 8633 Home

ADDRESS 175 Meadow Oak Dr. Statesville

LOCATION 115 N TR Sullivan Fm Rd at int ant rt at Schipley Ford Rd

SUBDIVISION Meadow Oaks BLOCK / SECTION LOT 57 LOT AREA 1.21 acres SITE CLASS. PS DESIGN FLOW 360 L.T.A.R. .35

Septic Tank: 1000 Gallons: STB 1012 Date 6-25-97

Pump Tank: Gallons: PT Date

Pump Make: Model Serial No.

Nitrification Field: No Fields 1 Square Feet 1200 Linear Feet 400

No Lines 4 Trench Width 36" Max Trench Bottom Depth 36" Gravel Depth 12"

☐ New System ☐ Repair System Type: ☒ III, IV, V, VI

System Description: Conv. Gravity

Repair System Description: " "

Maintenance Agreement Required: ☐ Yes ☒ No

☒ House/Mod. Home No. Bedrooms 3

☐ Mobile Home No. Bathrooms 2

☐ Business No. Employees

☐ Other


☐ Slab ☒ Crawl Space ☐ Basement w/plumbing ☐ Basement wo/plumbing

Water Supply: ☐ Individual ☐ Community ☒ Public


Comments:

Comments:

INITIAL SITE SKETCH

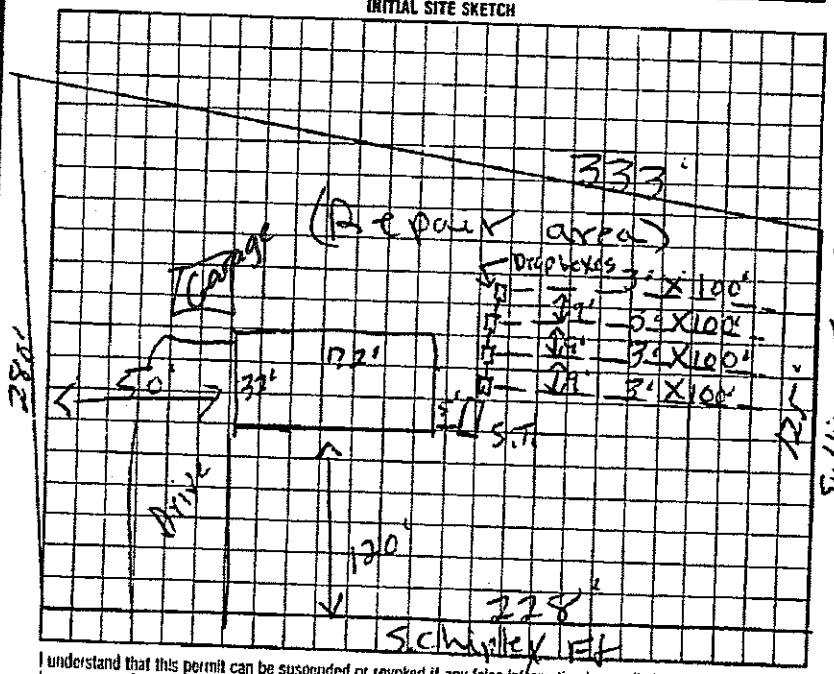

AS BUILT SKETCH

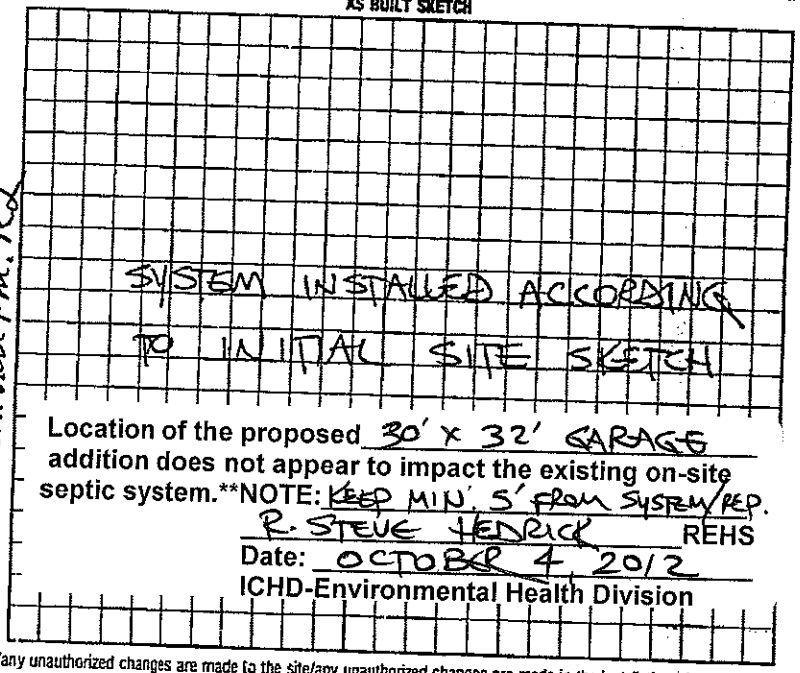

Location of the proposed 30' x 32' GARAGE addition does not appear to impact the existing on-site septic system.**NOTE: KEEP MIN. 5' FROM SYSTEM/REP.

R. STEVE HEDRICK REHS

Date: OCTOBER 4 2012

ICHD-Environmental Health Division

I understand that this permit can be suspended or revoked if any false information is supplied toward securing the permit/any unauthorized changes are made to the site/any unauthorized changes are made in the installation of the system. Improvement Permit is valid for 60 months from date of issuance.

Signed: J. Todd Ellis

Improvement Permit by: D. C. Moore date 6-4-97

Authorization to Install by: D. C. Moore date 6-4-97

Existing System Inspection by:

Installed by: DAVID YOUNTZ

Certificate of Completion by: date

Operation Permit by: STEVE HEDRICK date 9-4-97

HEALTH DEPT COPY: WHITE INSPECTION COPY (FINAL): GREEN OWNER COPY (FINAL): YELLOW INSPECTION COPY (INITIAL): PINK OWNER COPY (INITIAL): GOLD

to connect Authorization to Count. Expires 60 mos from issue