1234 Enter

IREDELL COUNTY HEALTH DEPARTMENT

STATESVILLE 704-878-5305 CI MOORESVILLE 704-664-5281

IMPROVEMENT PERMIT / AUTHORIZATION TO CONSTRUCT / OPERATION PERMIT / EXISTING SYSTEM INSPECTION

PERMIT# 126786 PIN# 4736-41-4087 ROB Wright DATE 4-20-05

OWNER OR CONTRACTOR RW WRIGHT CONSTRUCTION PHONE: Business 704-902-1443 Home

ADDRESS 164 FOX GLOVE DRIVE STATESVILLE, NC 28625

LOCATION 21 N (L) Ft. DOBBS RD (R) CHIPLEY FORD ON LEFT

SUBDIVISION MEADOW OAKS BLOCK / SECTION LOT 57 LOT AREA 0.957 SITE CLASS. PS DESIGN FLOW 480 L.T.A.R. .3

Septic Tank: 1000 Gallons; STB 1012 Date 6-12-05
Pump Tank: 1000 Gallons; PT 17 Date 8-14-05
Pump Make: Goulds Model WE05 1/H Serial No. J0567661
Nitrification Field: No Fields 1 Square Feet EQ=1600 Linear Feet 400'
No Lines 5×80' Trench Width 36" MIN Trench Bottom Depth 36" Gravel Depth N/A

☒ New System ☐ Repair System Type: I, II, (III), IV, V, VI
System Description: Pump 25% Reduct
Repair System Description: LP 50% Reduct
Maintenance Agreement Required: ☐ Yes ☒ No
☐ Slab ☒ Crawl Space ☐ Basement w/plumbing ☐ Basement wo/plumbing


☒ House/Mod. Home ☐ Mobile Home ☐ Business ☐ Other
No. Bedrooms 4 No. Bathrooms 3 No. Employees

Water Supply: ☐ Individual ☒ Public ☐ Community


Comments:/Conditions: (1) DO NOT CUT FOR POSITIVE DRAINAGE. KEEP HOUSE OUT OF GROUND & BACKFILL FOR POSITIVE DRAINAGE REQMTS. (2) INSTALL LINES ON CONTOURS & MAINTAIN SETBACKS (3) HOUSE & SYSTEM IS FLAGGED.

Comments:/Conditions: (X) NOTE: INSTALL LINES AT 36" TRENCH BOTTOM (X)

INITIAL SITE SKETCH 1"=50'

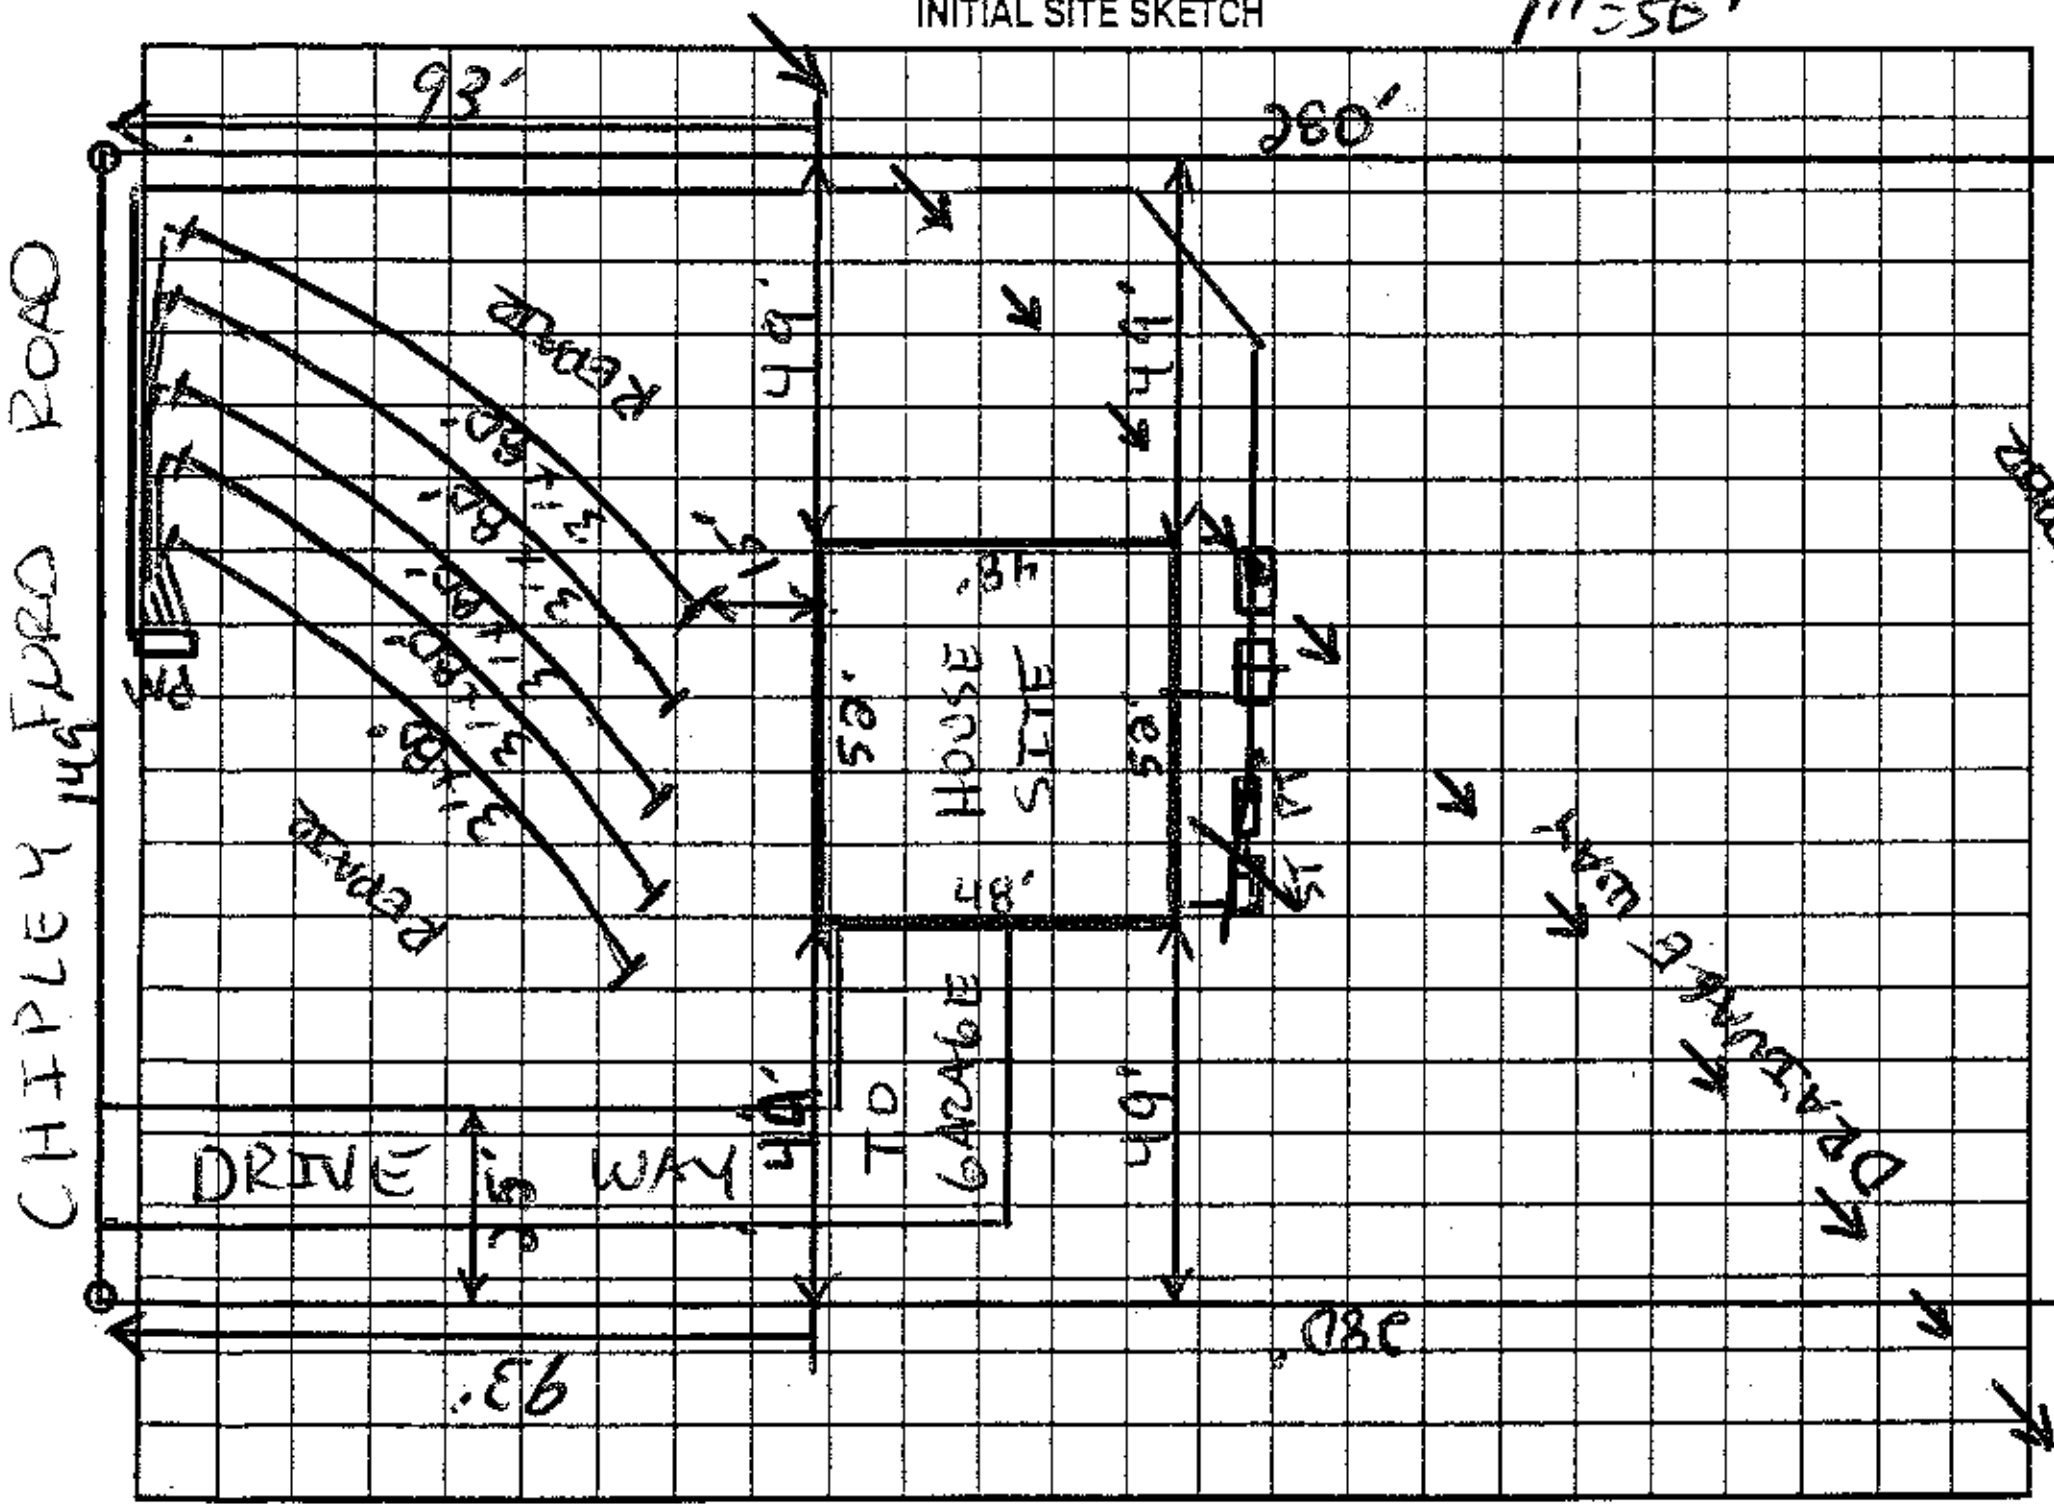

AS BUILT SKETCH

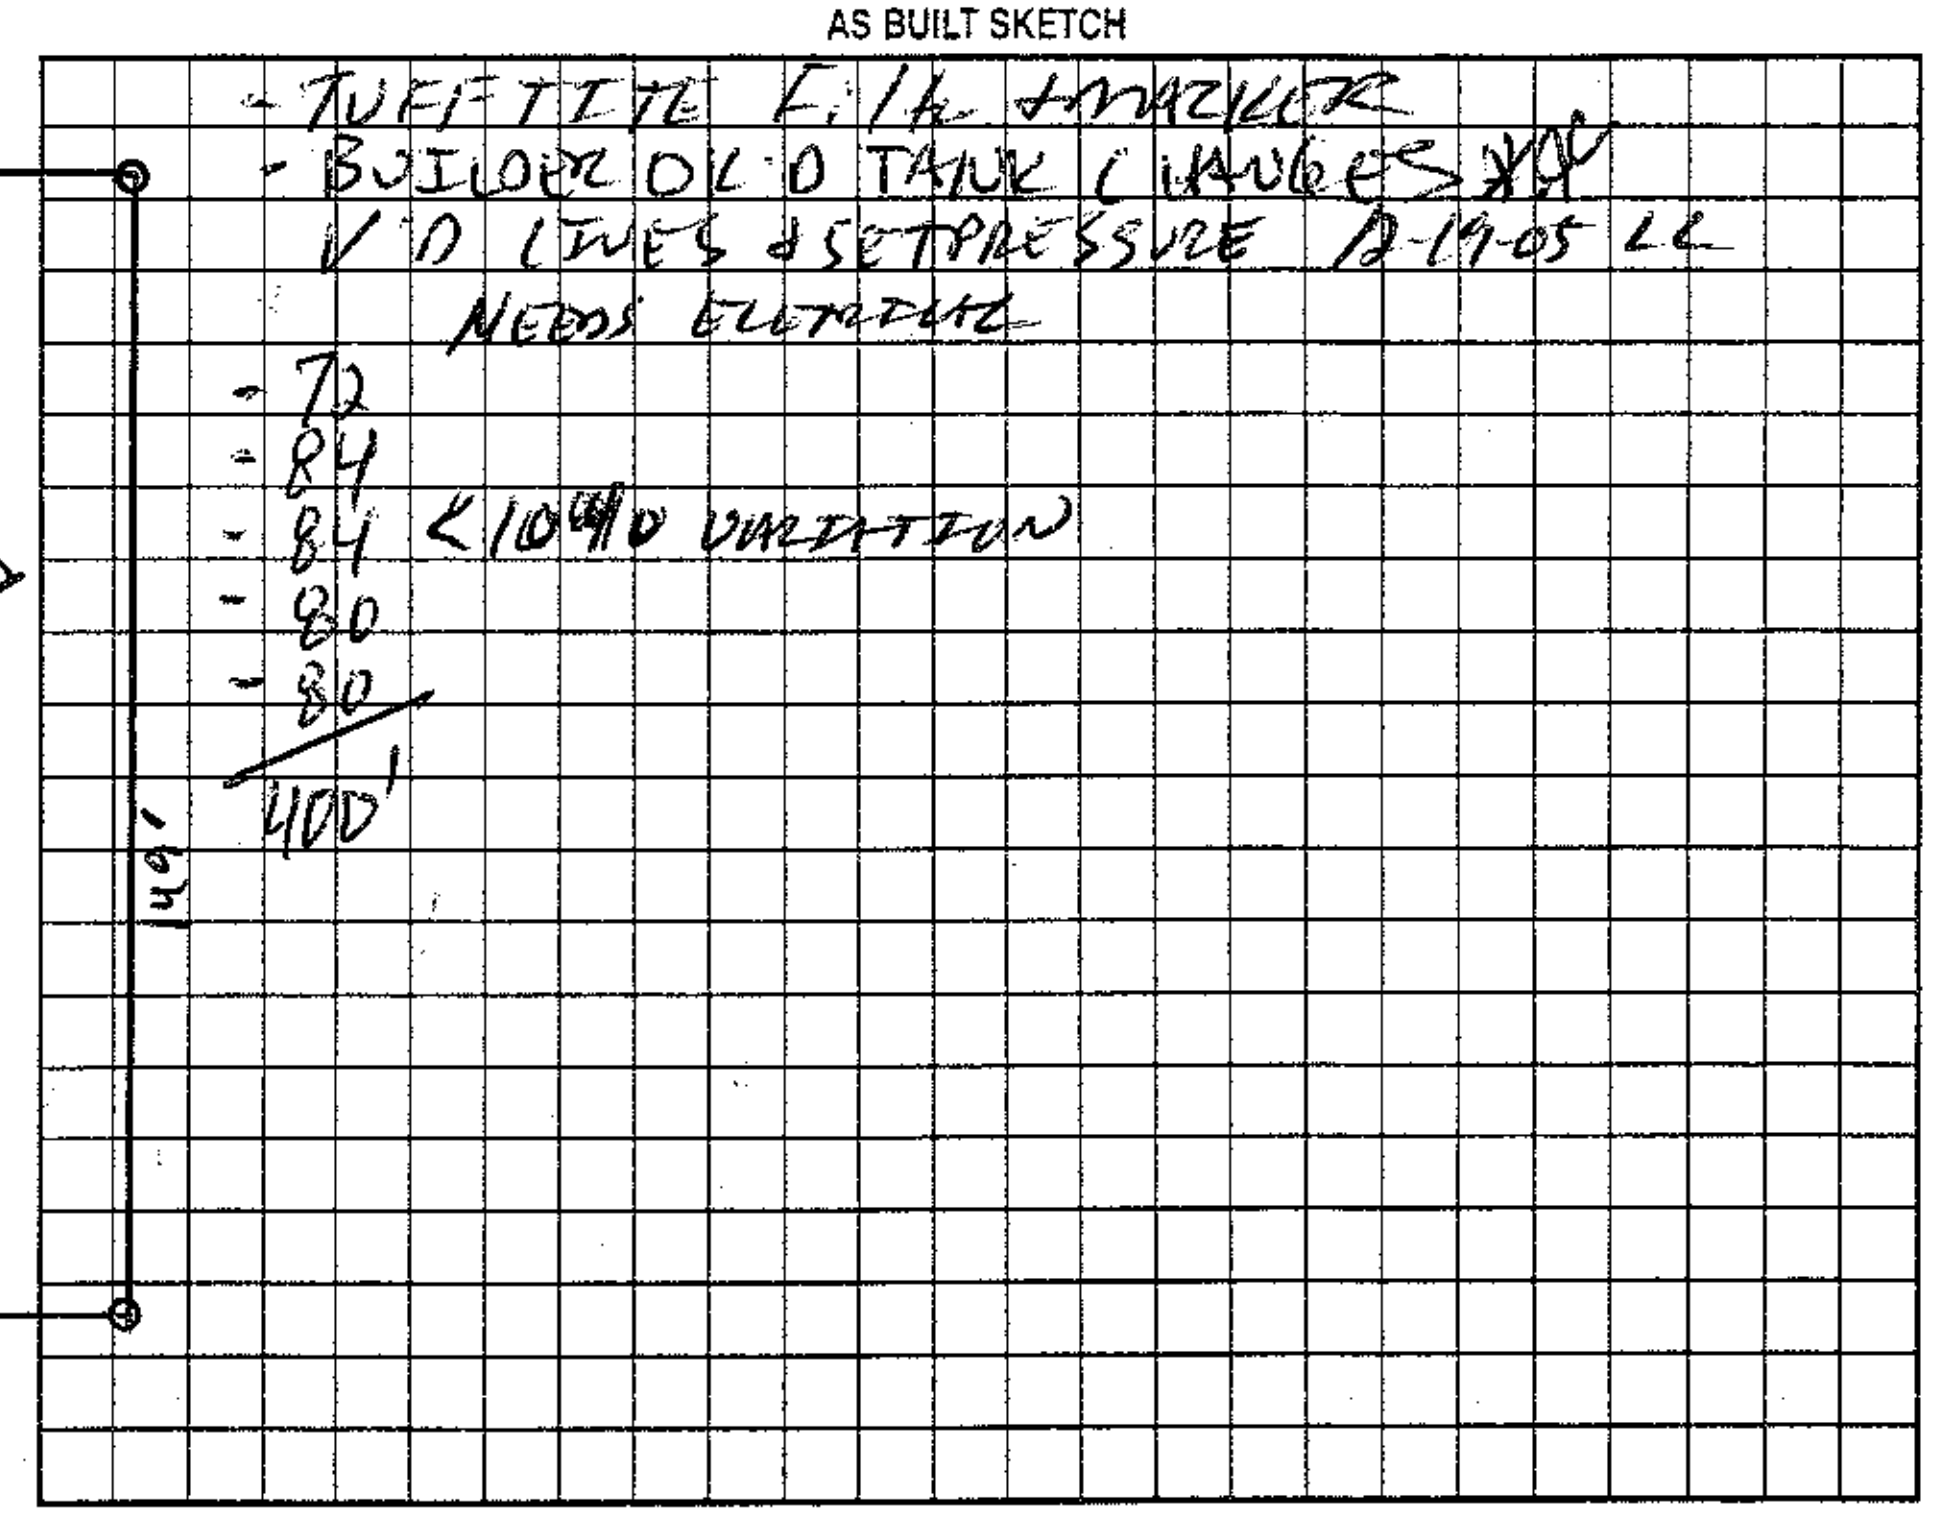

Permit can be suspended or revoked if any false information is supplied toward securing the permit/any unauthorized changes are made to the site/any unauthorized changes are made in the installation of the system. Improvement Permit with plat valid without expiration. Improvement Permit with site plan valid for sixty months. Authorization to Construct is valid for a period equal to that of Improvement Permit – not to exceed sixty months.

Signed: Rob Wright date 5-17-05 Installed by: Danny Pyle

Improvement Permit by: [signature] date 4-20-05 Operation Permit by: [signature] date 7-17-06

Authorization to Construct by: [signature] date 4-20-05 Existing System Inspection by: date

HEALTH DEPT. COPY: WHITE OWNER COPY (FINAL): YELLOW OWNER COPY (INITIAL): PINK