# IREDELL COUNTY HEALTH DEPARTMENT

STATESVILLE 704-878-5305 MOORESVILLE 704-664-5281

## IMPROVEMENT PERMIT / CERTIFICATE OF COMPLETION / OPERATION PERMIT / EXISTING SYSTEM INSPECTION

PROPERTY DESCRIPTION NO. Repair DATE 8-5-97 TAX MAP NO. Repair Watershed: ☐ Yes ☐ No

OWNER OR CONTRACTOR Kathleen Scott PHONE: Business _____ Home _____

ADDRESS 2298 Chipley Ford Rd Statesville

LOCATION 115N To Chipley Ford Rd on right past Fort Dobbs Rd

SUBDIVISION _____ BLOCK / SECTION _____ LOT _____ LOT AREA _____ SITE CLASS. _____ DESIGN FLOW _____ L.T.A.R. _____

Septic Tank: 1000 Gallons; STB 1012 Date 6-10-97

Pump Tank: _____ Gallons; PT _____ Date _____

Pump Make: _____ Model _____ Serial No. _____

Nitrification Field: No Fields 2 Square Feet _____ Linear Feet 300

No Lines 3 Trench Width 36in Max Trench Bottom Depth 30in Gravel Depth 12in

☐ New System ☒ Repair System Type: I (II) III, IV, V, VI

System Description: _____

Repair System Description: Gravity Convention

Maintenance Agreement Required: ☐ Yes ☐ No

☒ House/Mod. Home No. Bedrooms 3

☐ Mobile Home No. Bathrooms 3½

☐ Business No. Employees ____

☐ Other _____


☐ Slab ☐ Crawl Space ☒ Basement w/plumbing ☐ Basement wo/plumbing

Water Supply: ☒ Individual ☐ Community ☐ Public


Comments: Keep lines on contour 9ft on center
Try to Tie in old lines,

Comments:
* Did not use old lines

**INITIAL SITE SKETCH**

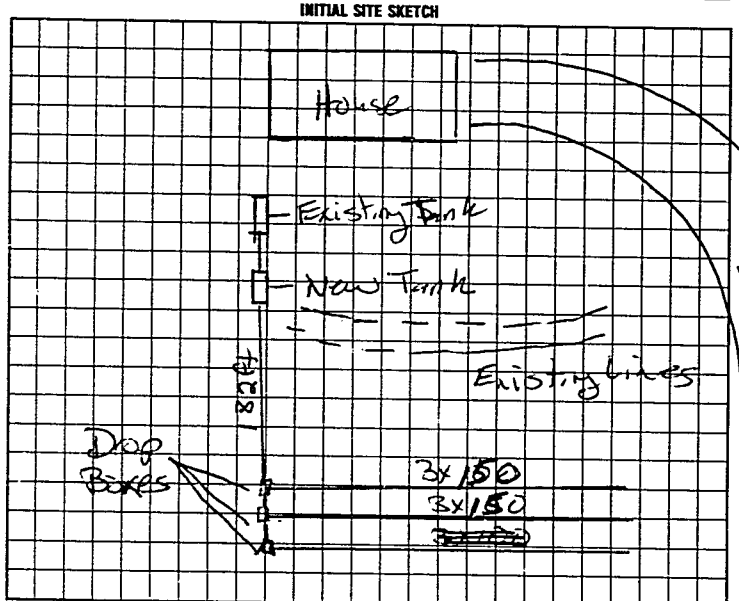


**AS BUILT SKETCH**

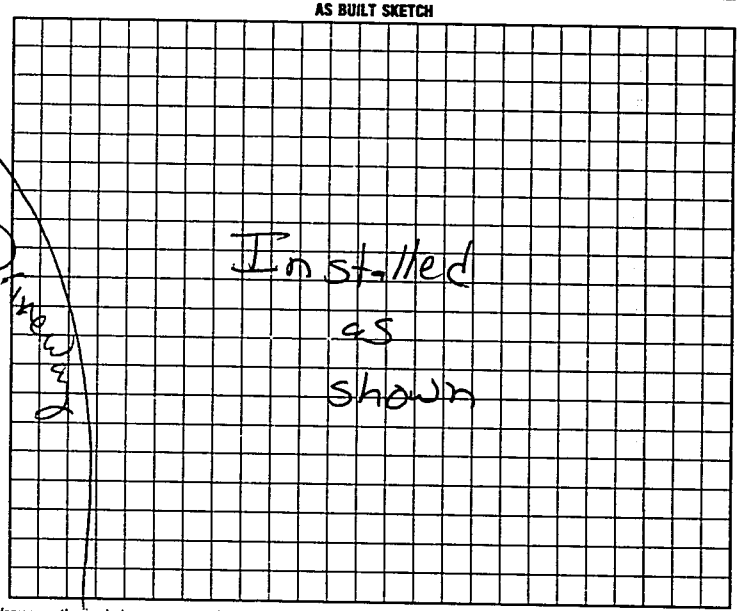


I understand that this permit can be suspended or revoked if any false information is supplied toward securing the permit/any unauthorized changes are made to the site/any unauthorized changes are made in the installation of the system. Improvement Permit is valid for 60 months from date of issuance.

Signed: _____

Improvement Permit by: Mark C. Cox RS date 8-5-97

~~Existing System Inspection by:~~ Authorization Mark C. Cox RS date 8-5-97

Installed by: David Yantz

Certificate of Completion by: _____ date _____

Operation Permit by: Mark C. Cox RS date 8-15-97

HEALTH DEPT. COPY: WHITE INSPECTION COPY (FINAL): GREEN OWNER COPY (FINAL): YELLOW INSPECTION COPY (INITIAL): PINK OWNER COPY (INITIAL): GOLD

0 5 5 2 0 0