IREDELL COUNTY HEALTH DEPARTMENT

Statesville Phone TR 3-7271

Mooresville Phone NO 3-1271

PERMIT TO INSTALL SEPTIC TANK

Permit No. 219

Permit Date April 8 1971

Owner Hope Bros. Builders Inc. Address Statesville, NC

Installed By Lackey Bros. Address Stony Point, NC


Location of Property Chipley Park - (Road # 1846) Turn Left 3rd St. House on Left

Tank		Capacity		Length of Lines		Fixtures	
Block	( )	1000	(✓)	225'	( )	No. of Baths	(2)
Precast	(✓)	1250	( )	250'	( )	Dishwasher	( )
		1500	( )	Other 300		Garbage Grdr.	( )
		Other				Other	

NOTIFY HEALTH DEPARTMENT AT LEAST EIGHT HOURS BEFORE TANK IS TO BE INSPECTED.

Final Inspection April 8 1971 Approved (✓) Disapproved ( )

Remarks Community Water Supply

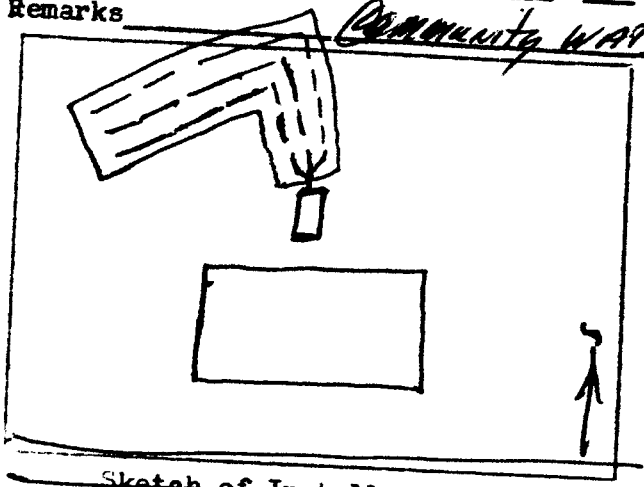

Sketch of Installation

Sanitarian