IREDELL COUNTY HEALTH DEPARTMENT

Statesville Phone TR 3-7271 Mooresville Phone NO 3-1271

PERMIT TO INSTALL SEPTIC TANK

Permit No. _____ Permit Date 9-5 1968

Owner Hope Builders Address St. Ivesville, N.C.

Installed By Hope Bros. Address Statesville, N.C.

Location of Property 115 & Chipley Park Road


End Rd. Last House on left.

Tank		Capacity		Length of Lines		Fixtures	
Block	( )	1000	(✓)	225'	( )	No. of Baths	( )
Precast	( )	1250	( )	250'	( )	Dishwasher	( )
		1500	( )	Other _____		Garbage Grdr.	( )
		Other _____				Other _____	

NOTIFY HEALTH DEPARTMENT AT LEAST EIGHT HOURS BEFORE TANK IS TO BE INSPECTED.

Final Inspection 9-6 1968 Approved (✓) Disapproved ( )

Remarks The Well on property

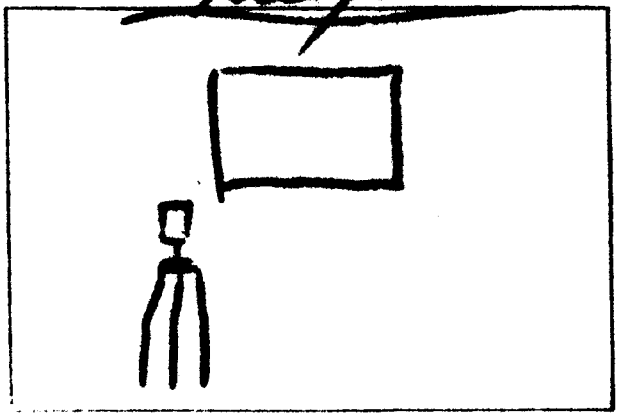

Sketch of Installation

Andrew J. Hutchins R.S.

Sanit arian